

RECEIVED

JUL 29 2022

OWRD

SURFACE WATER BENEFICIAL USE MAP APPLICATION S-86298/PERMIT S-54491 4-25-19

T.26S., R.5W., WILLAMETTE MERIDIAN DLC NO. 47




Expires Dec. 31, 2022

DATE SURVEYED 3-30-2022

RECEIVED

AUG 19 2022


OWRD

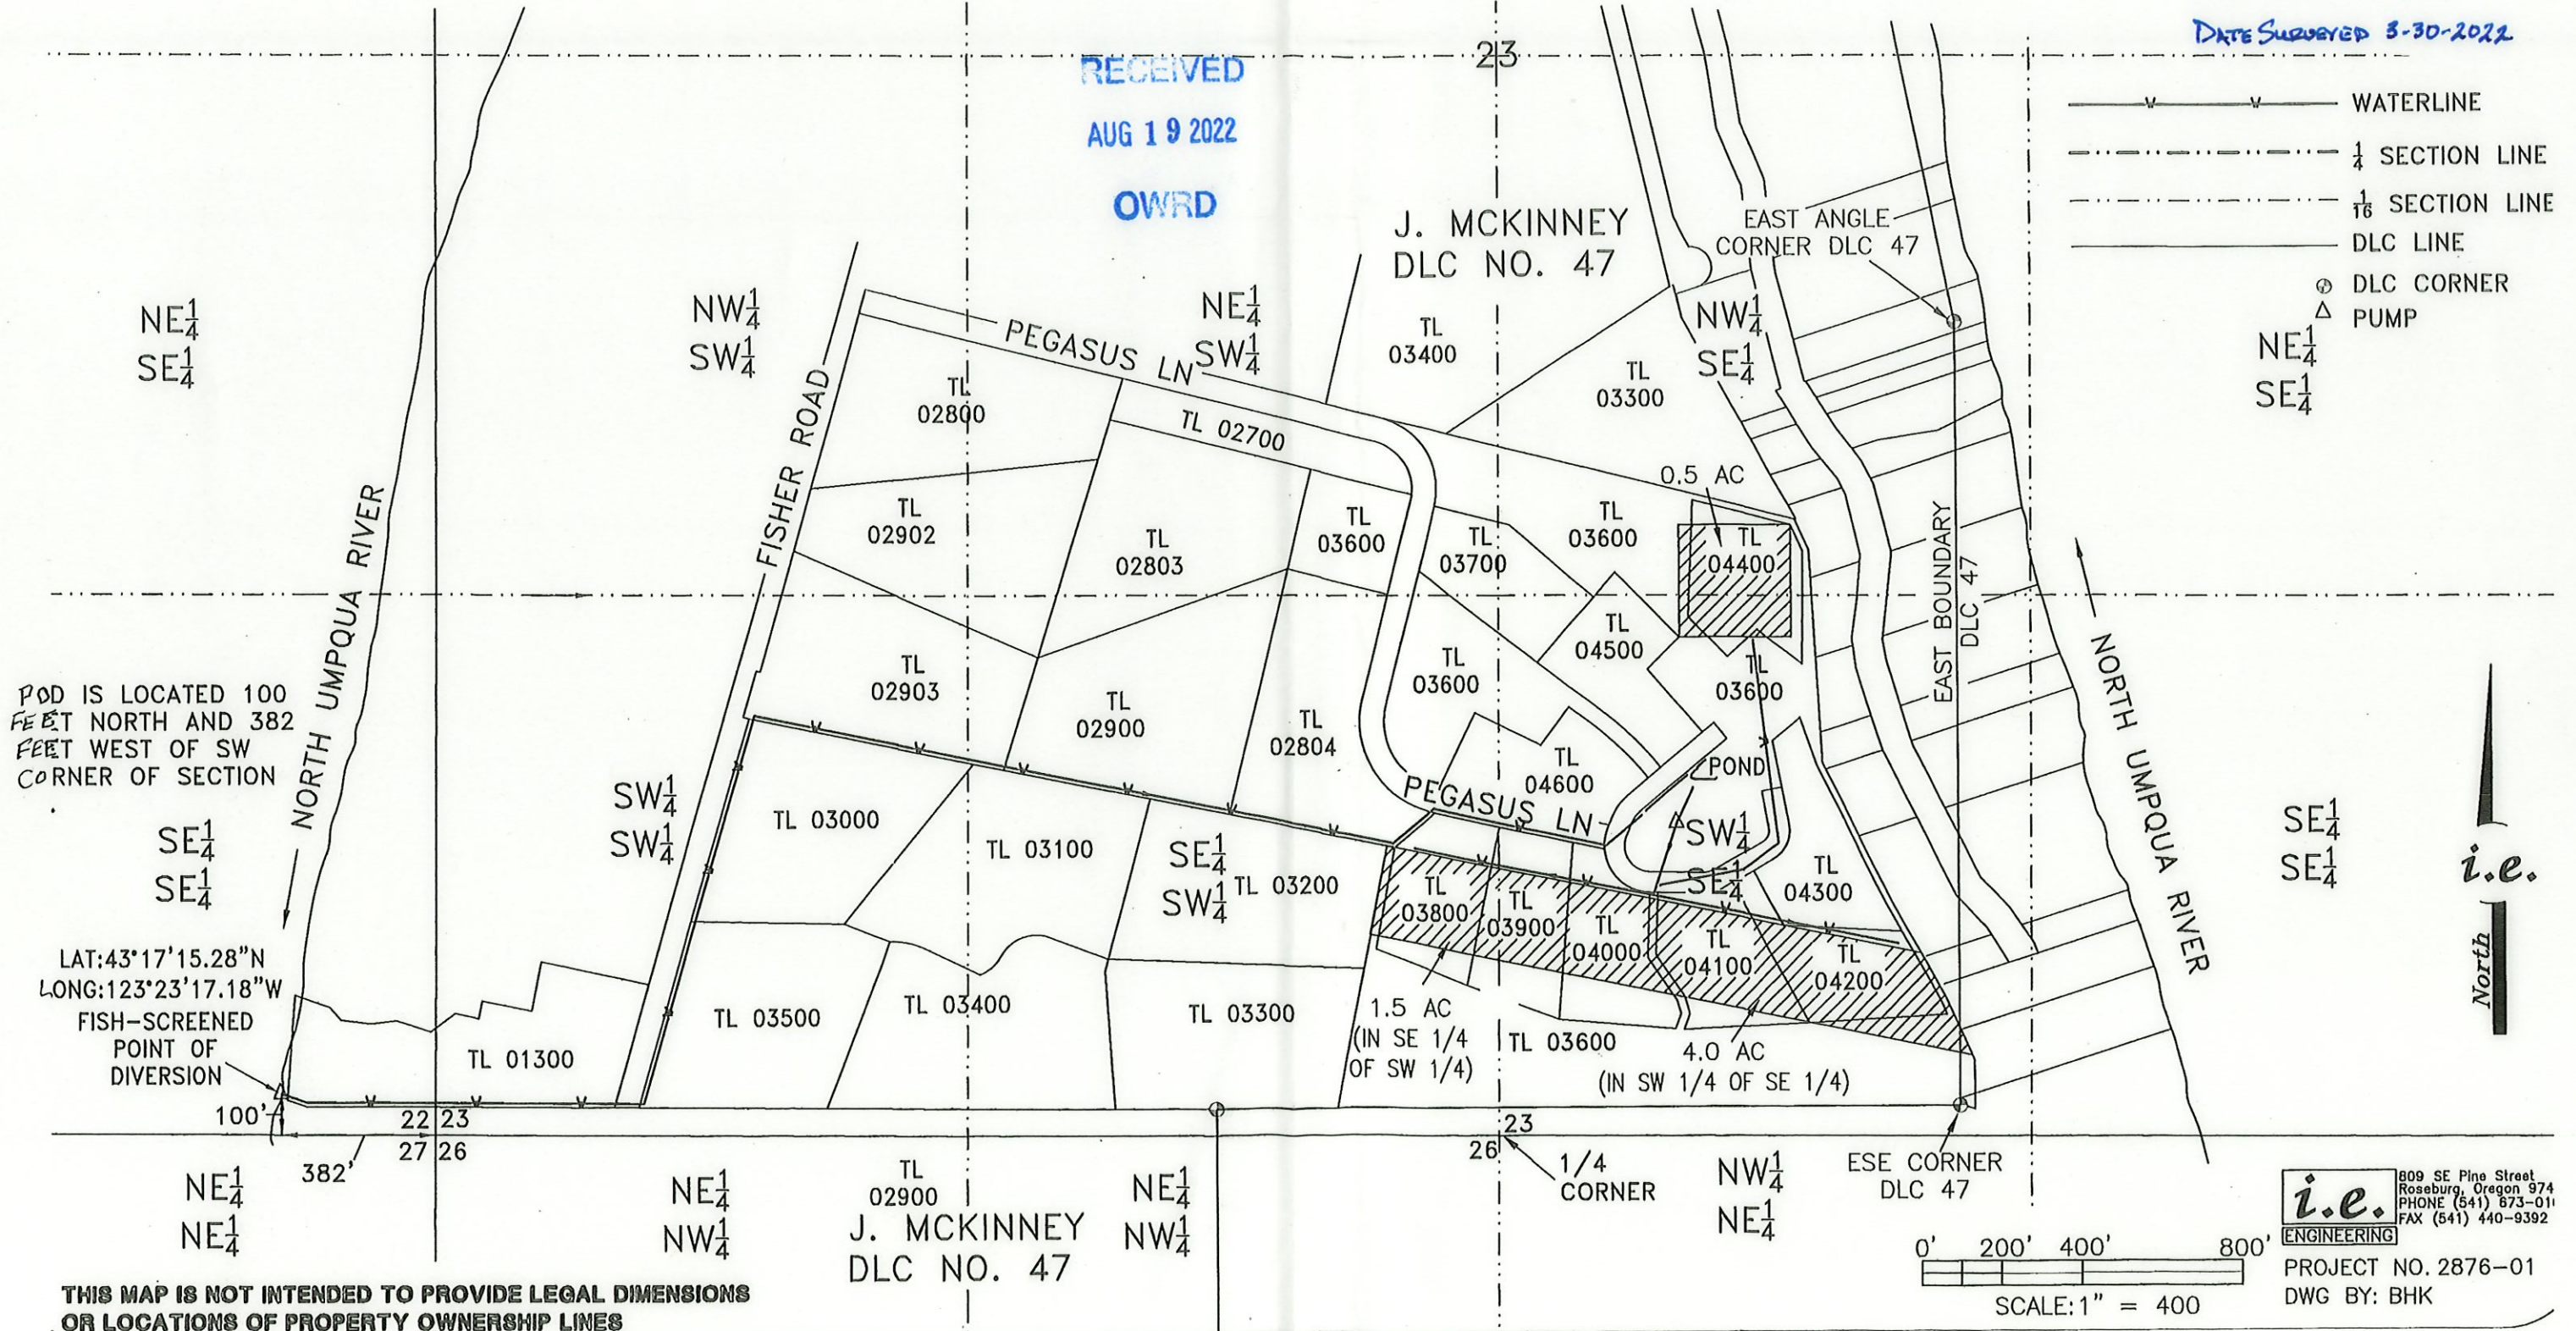

- v ——— WATERLINE
- 1/4 SECTION LINE
- 1/16 SECTION LINE
- DLC LINE
- ⊕ DLC CORNER
- △ PUMP

NE 1/4
SE 1/4

SE 1/4
SE 1/4

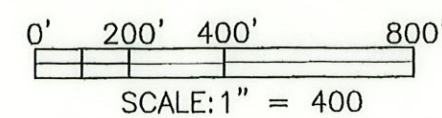

i.e.
ENGINEERING
809 SE Pine Street
Roseburg, Oregon 974
PHONE (541) 673-0111
FAX (541) 440-9392

PROJECT NO. 2876-01
DWG BY: BHK

THIS MAP IS NOT INTENDED TO PROVIDE LEGAL DIMENSIONS OR LOCATIONS OF PROPERTY OWNERSHIP LINES