


R 39 E T 3 S

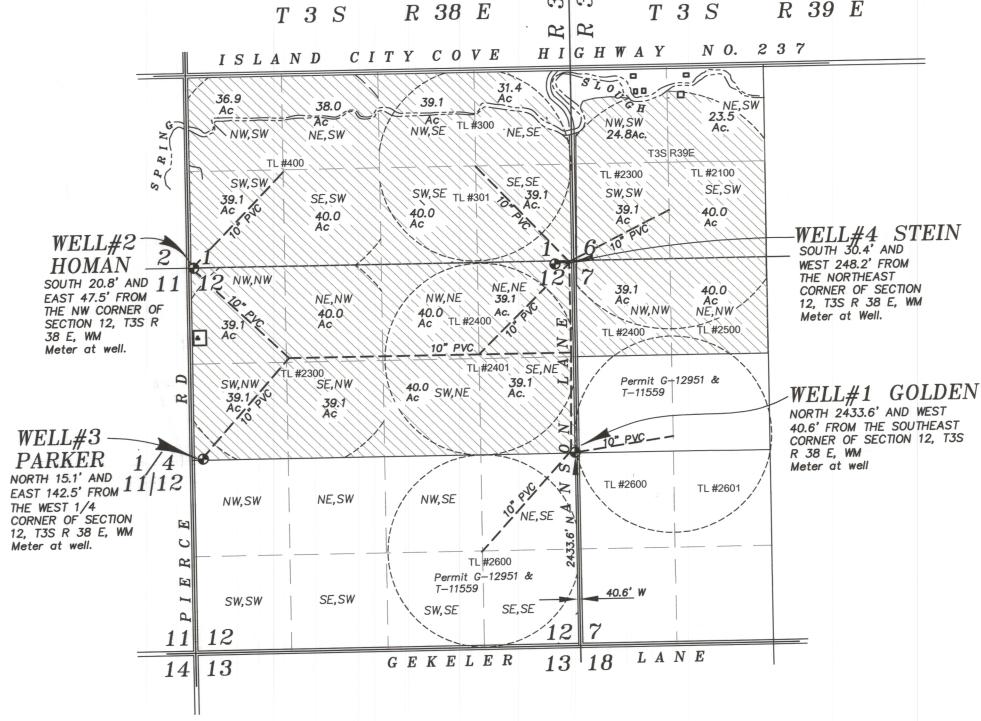

Lands irrigated from existing wells, Golden, Stein, Homan, and Parker as authorized under Permit G-13254.

Mainline



NOTE: The preparation of this map was for the purpose of identifying the location of the proposed water right and has no intent to provide dimensions of location of property ownership lines Location information shown here Location was furnished by the applicant was furnished by

### WELL GPS POSITIONS

- I		
Well Name	Latitude	Longitude
"HOMAN WELL"	N 45°19'32.9549"N	118°00'50.9421"W
"PARKER WELL"	N 45°19'07.0935"N	118°00'49.6633"W
"GOLDEN WELL"	N 45°19'04.8518"N	117°59'38.1593"W
"STEIN WELL"	N45°19'32.9293"N	117°59'41.0049"W



# SCALE: 1"=1320'

## WELL NAMES

Well #1 as identified under original application map reported water usage under the name of "GOLDEN", and now the well name.

Well #2 as identified under original application map reported water usage under the name of "HOMAN", and now the well name.

Well #3 as identified under original application map just completed in 2021 now known as "PARKER"

Well #4 identified under original application map reported water usage under the name of "STEIN", and now the well name.

### NOTE: CORNER IRRIGATION

Most all of the land depicted in this COBU is watered by existing pivots, three of which have swing arms attached. Mr. John Frisch, farm manager for MDB FARMS LLC told me that he uses hand lines when planting the corners not irrigated by pivot to start the grain seed in the spring or fall as needed. He indicated that he has a diary with dates, as well as pictures of the hand irrigation when used. I was satisfied with his explaination that the land had been watered in the last 5 years.

August 5, 2022

CLAIM OF BENEFICIAL USE MAP FOR LANDS UNDER PERMIT G-13254 FOR FOUR WELLS FOR IRRIGATION AS ISSUED TO MDB FARMS LLC

> BAGETT-GRIFFITH & BLACKMAN 2006 ADAMS AVENUE LA GRANDE, OREGON 97850

APPLICA7	TION NO.	G-14291	1
PFRMIT	NO.	G-13254	