

Request for Assignment - Caleb Foster and Nina m Buty Foster to Northwest Farm Credit Services, FLCA and Petros Holdings, LLC

Northwest Farm Credit Services

UAAR®

Portion to assign

File # 19-PetrosHoldings-297SH

RECEIVED

FEB 28 1994

WATER RESOURCES DEPT. SALEM, OREGON


T. 6N., R. 35E., W.M.

UMATILLA COUNTY

SCALE 1" = 400'

Ctr. Sec.

35

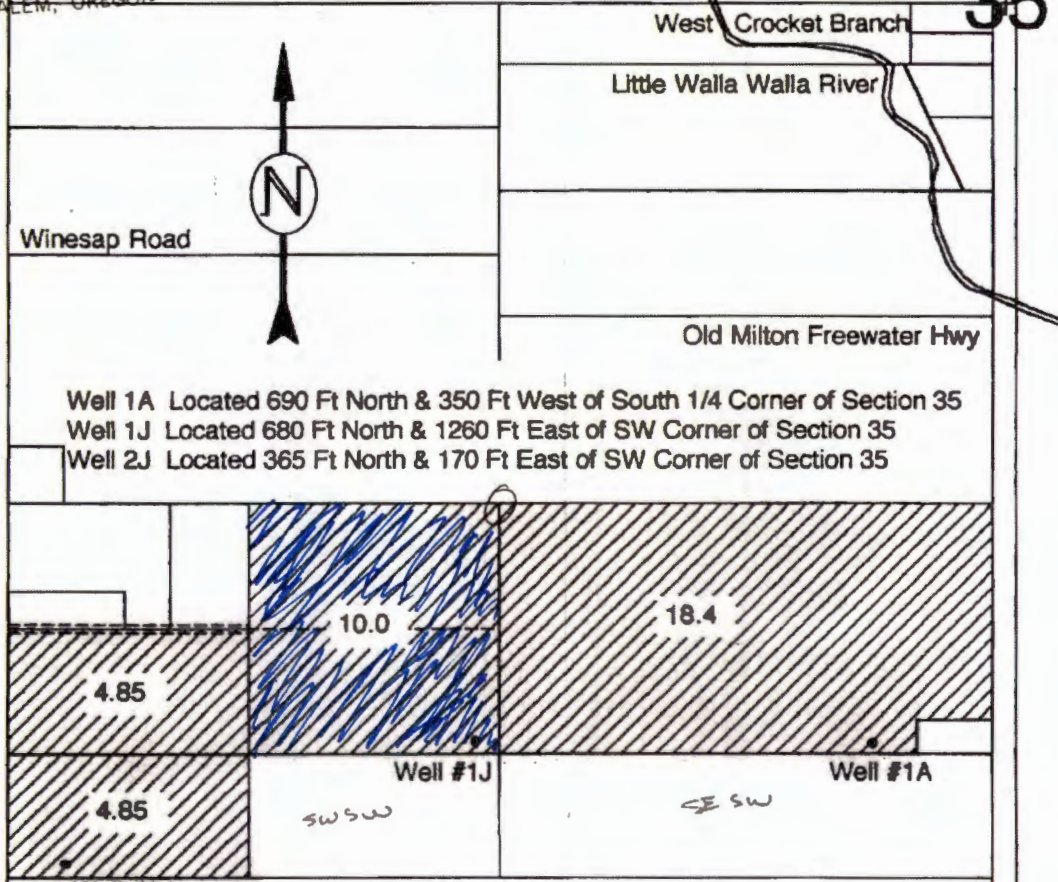

Well 1A Located 690 Ft North & 350 Ft West of South 1/4 Corner of Section 35
 Well 1J Located 680 Ft North & 1260 Ft East of SW Corner of Section 35
 Well 2J Located 365 Ft North & 170 Ft East of SW Corner of Section 35


WATER RIGHTS APPLICATION MAP

Water Rights Applied for at This Location

IN NAME OF

Alex LeFore

THIS MAP IS FOR THE PURPOSE OF IDENTIFYING THE LOCATION OF WATER RIGHTS ONLY AND IS NOT INTENDED TO PROVIDE THE LEGAL DIMENSIONS OR LOCATIONS OF PROPERTY OWNERSHIP LINES.

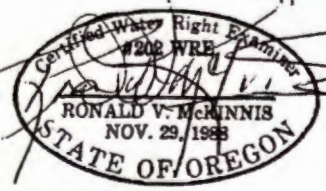

ENGINEERING - SURVEYING - WATER RIGHTS
R V McKINNIS ENGINEERING
 Rt 1 Box 1122 Hermiston, Oregon 97838
 503-567-2017

Application No. 3617
Permit No. G13075

RECEIVED

AUG 03 2022

OWRD