


Township 3 South, Range 26 East, W.M.
 Sections 11, 12, and 14
 Morrow County

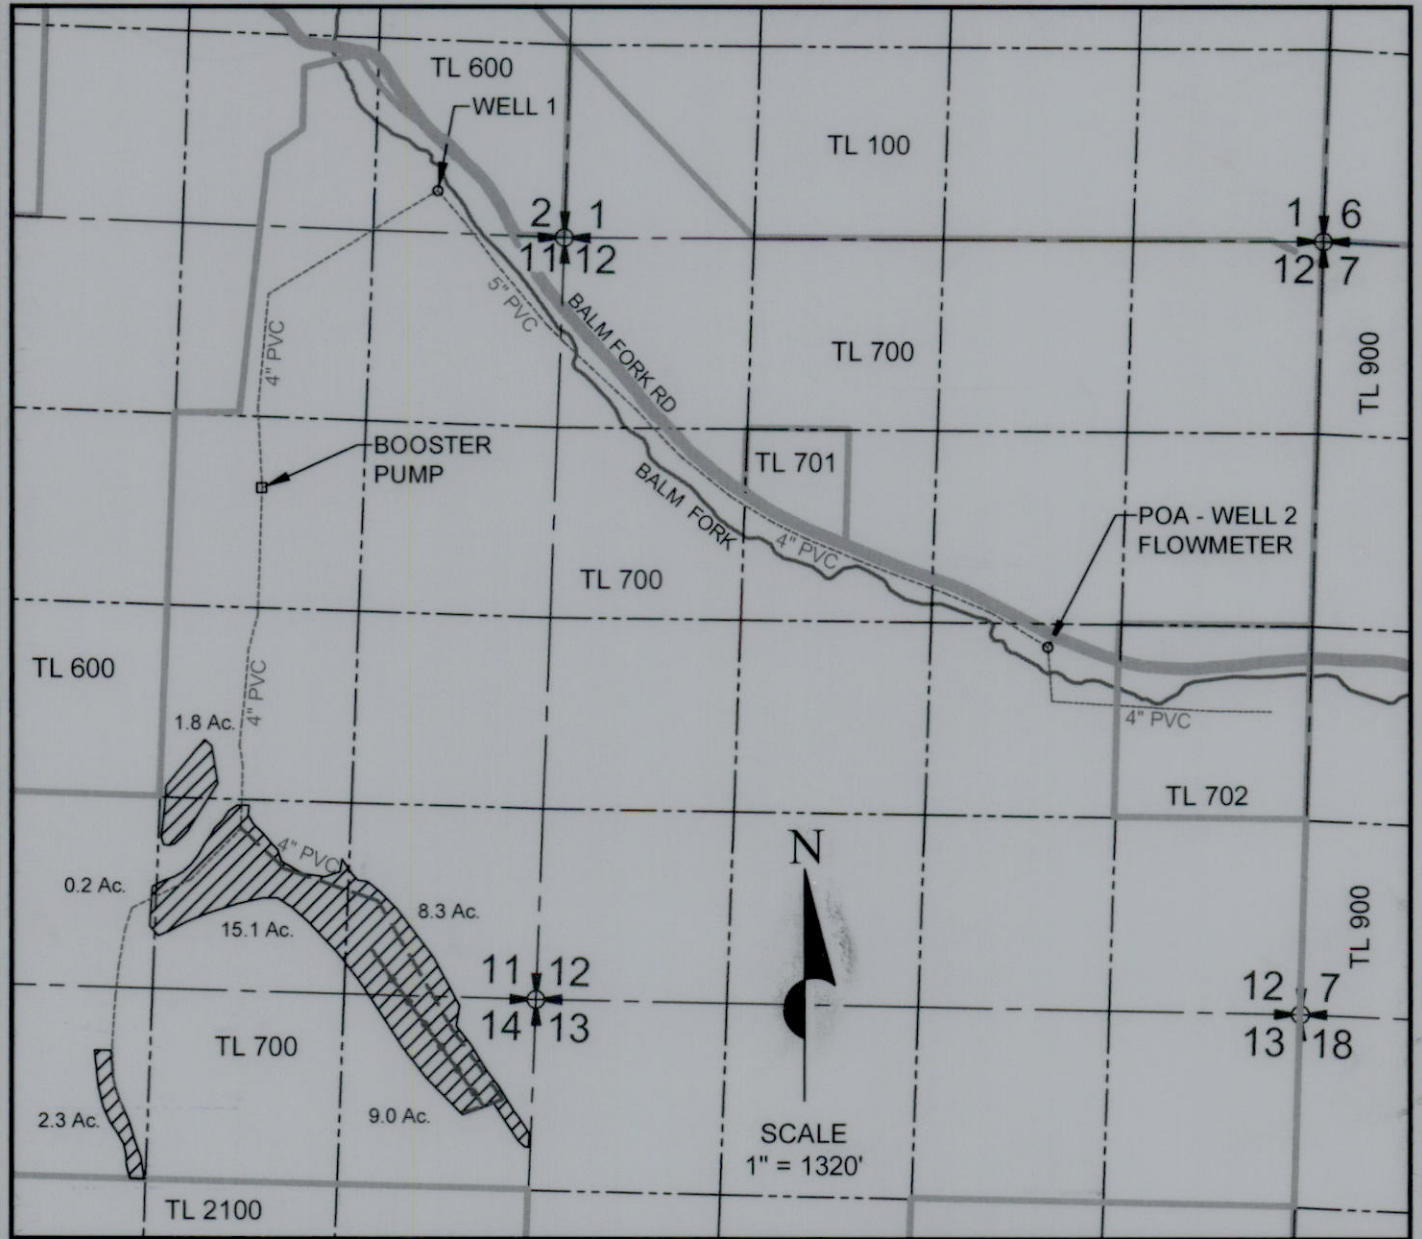


LEGEND

- SECTIONS
- - - - QTR-QTR SECTIONS
- TAX LOTS
- - - - BURIED PIPELINES (NEW)
- - - - BURIED PIPELINES (EXISTING)
- PORTABLE LINES
- WELLS
- BOOSTER PUMP
- ▨ 36.7 ACRES IRRIGATED

POA - WELL 2 LOCATION: TOWNSHIP 3 SOUTH, RANGE 26 EAST, SECTION 12; 2790 FEET SOUTH AND 3430 FEET EAST FROM NW CORNER OF SECTION 12.

COBU Map
 in name of
 ALBERT L. OSMIN
 2022

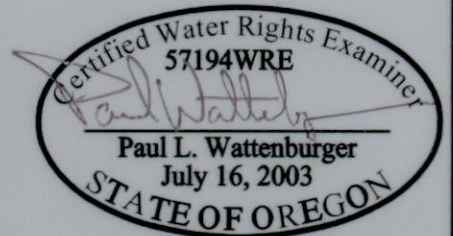

THIS MAP WAS PREPARED FOR THE PURPOSE OF DETERMINING THE LOCATION OF A WATER RIGHT ONLY AND DOES NOT SHOW LEGAL DIMENSIONS OR LOCATION OF PROPERTY.

RECEIVED
 AUG 26 2022
 OWRD

EXPIRES: 6/30/24