




Alternate Reservoir Application Map
Byrd Family Trust
T.25S. R.4W. Sections 4 & 9
Douglas County

RECEIVED

AUG 29 2022

OWRD

Scale: 1" = 1320'

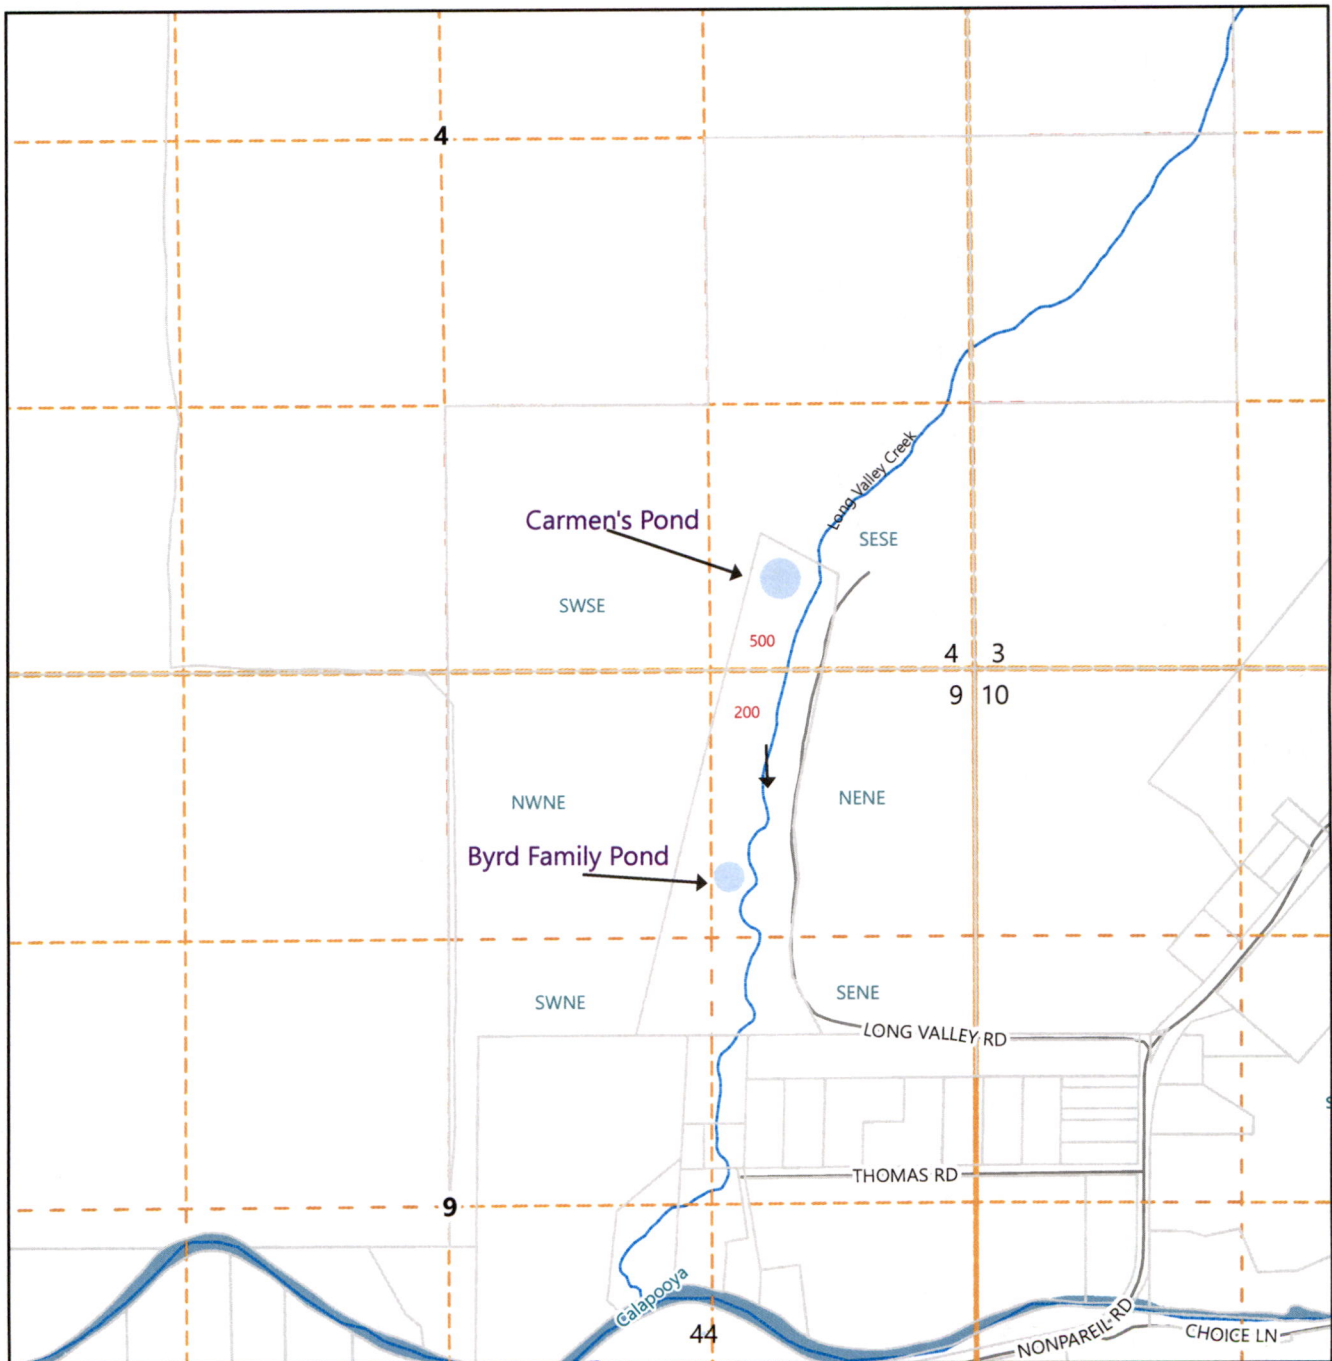

Carmen's Pond is 642 ft North and 1293 ft West
from the SE Section Corner 4

Byrd Family Pond is 1434 ft South and 1688 ft West
from the NE Section Corner 9

The purpose of this map is to identify
the location of a Water Right.
Not intended to show property ownership.