


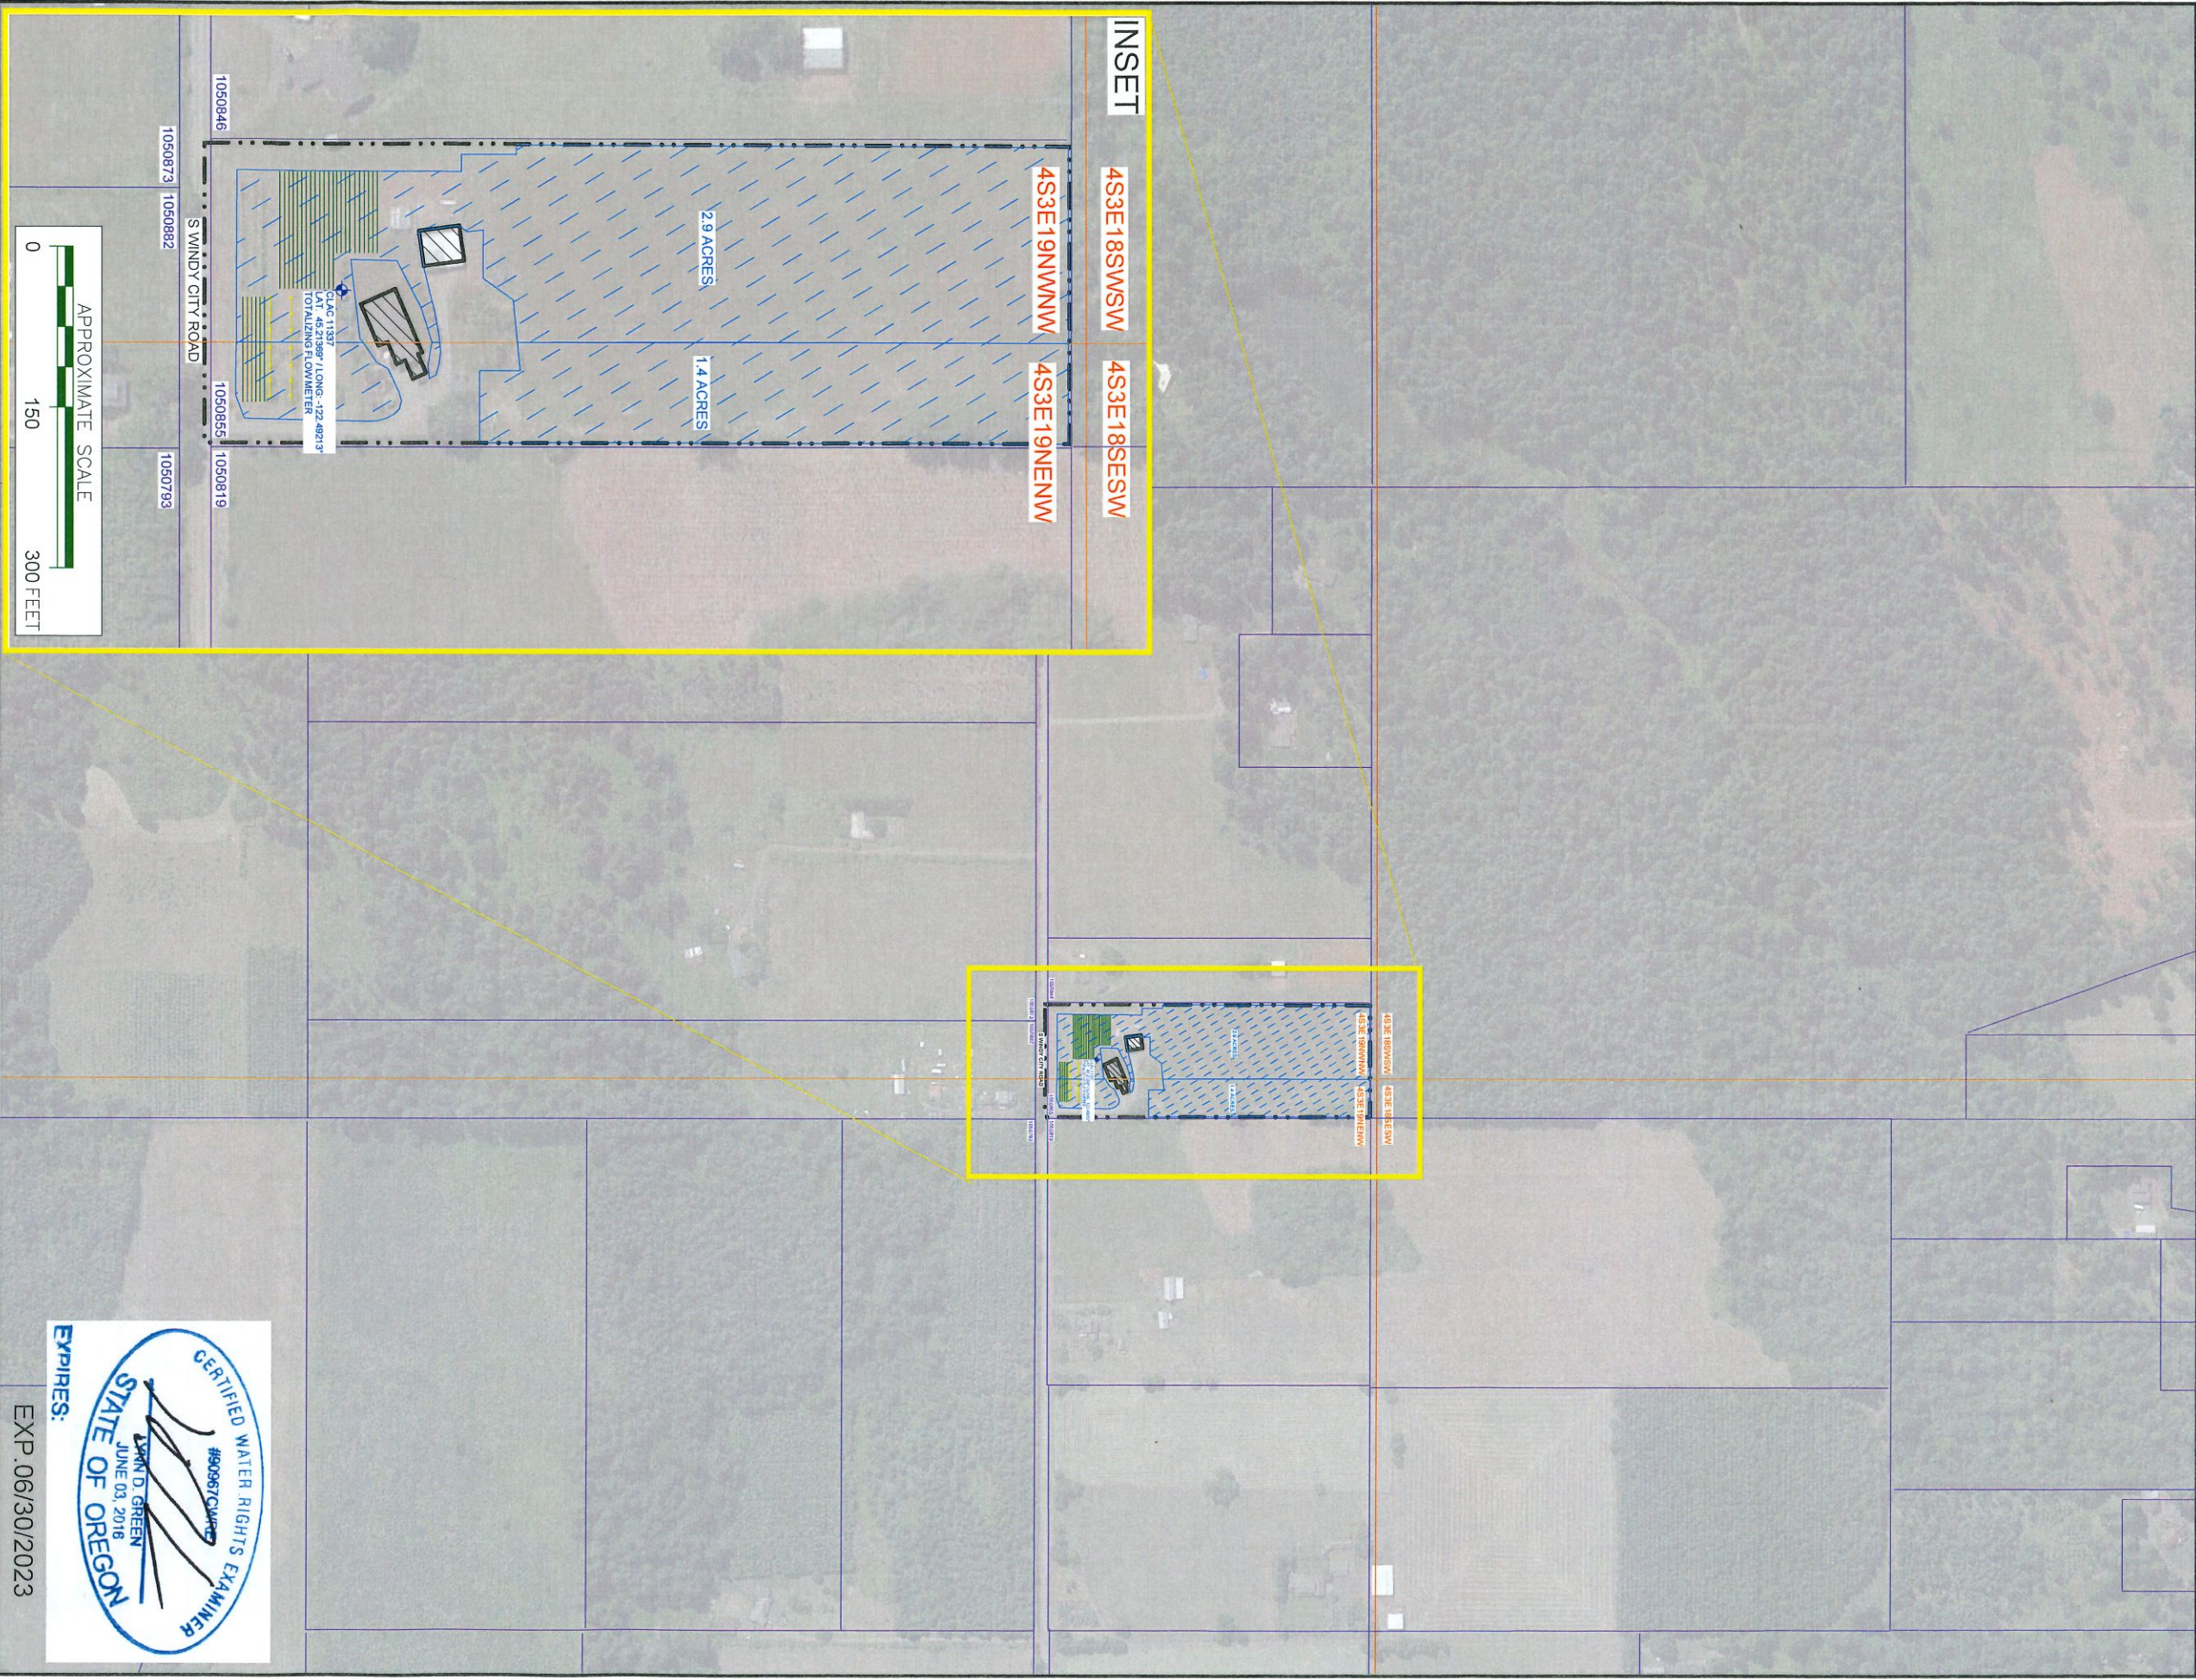

LEGEND:

- | | | | |
|--|---|--|-------------------|
| | SUBJECT PROPERTY BOUNDARIES | | TAXLOT BOUNDARIES |
| | POU1: IRRIGATION AREA | | SUBJECT BUILDINGS |
| | 4.3 ACRES TOTAL | | POA1, CLAC 11337 |
| | PUBLIC LAND SURVEY SYSTEM | | |
| | DRIP IRRIGATION LINES (OTHER AREAS BY PORTABLE SPRINKLER) | | |
| | HOSE AND NOZZLE IRRIGATION LINES | | |
| | APPLICATION # G-16633 / PERMIT # G-16154 | | |

NOTES:

1. BASE MAP DEVELOPED FROM AN AERIAL PHOTOGRAPH MAP DATED 2022 AND ENW FIELD NOTES.
2. THIS MAP IS NOT INTENDED TO PROVIDE LEGAL DIMENSION OR LOCATION OF PROPERTY OWNERSHIP LINES. ALL BUILDING, STREET, AND FEATURE LOCATIONS ARE APPROXIMATE.
3. SYMBOLS REPRESENT LOCATION AND DO NOT ALWAYS REPRESENT EXACT SHAPE, SIZE, OR ORIENTATION.



PO BOX 14488, PORTLAND, OREGON 97293
P: (503)452-5561, E: ENW@EVEN-NW.COM

FIGURE 2

SITE PLAN

RESIDENTIAL PROPERTY
18263 S WINDY CITY ROAD
MULINO, OREGON



RECEIVED

SEP 09 2022

OWRD