

SE 1/4 NW 1/4

SW 1/4 NE 1/4

TL 2500

TL 501

DIVERSION

POND

97'
S81°44'W

PUMP


S.E.

CHURCH

ROAD

NE 1/4 SW 1/4

LEGEND

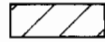

IRRIGATED LANDS

TL 100

312TH AVENUE S.E.

RECEIVED

OCT 01 1999


WATER RESOURCES DEPT



SCALE: 1" = 400'

This drawing is an exhibit for a Final Proof Survey. It is not a Land Survey. Property lines and/or other lines of occupation shown hereon are not represented by the undersigned to meet accuracy standards of Land Surveys.

SECTION 5, T. 2S., R. 4E., W.M.
CLACKAMAS COUNTY, OREGON

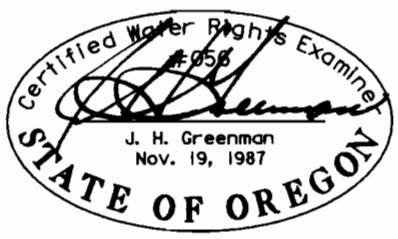

Application No. R-70090

Permit No. R-11538



HANER, ROSS & SPORSEEN, INC.
15 S.E. 82ND DRIVE
GLADSTONE, OREGON 97027

GLEN OAKES
FINAL PROOF SURVEY

620M

D:\apdata\620m\620m.dgn 09/28/99 ecf