


Measuring Tube Diagram and Specifications

Figure 200-5

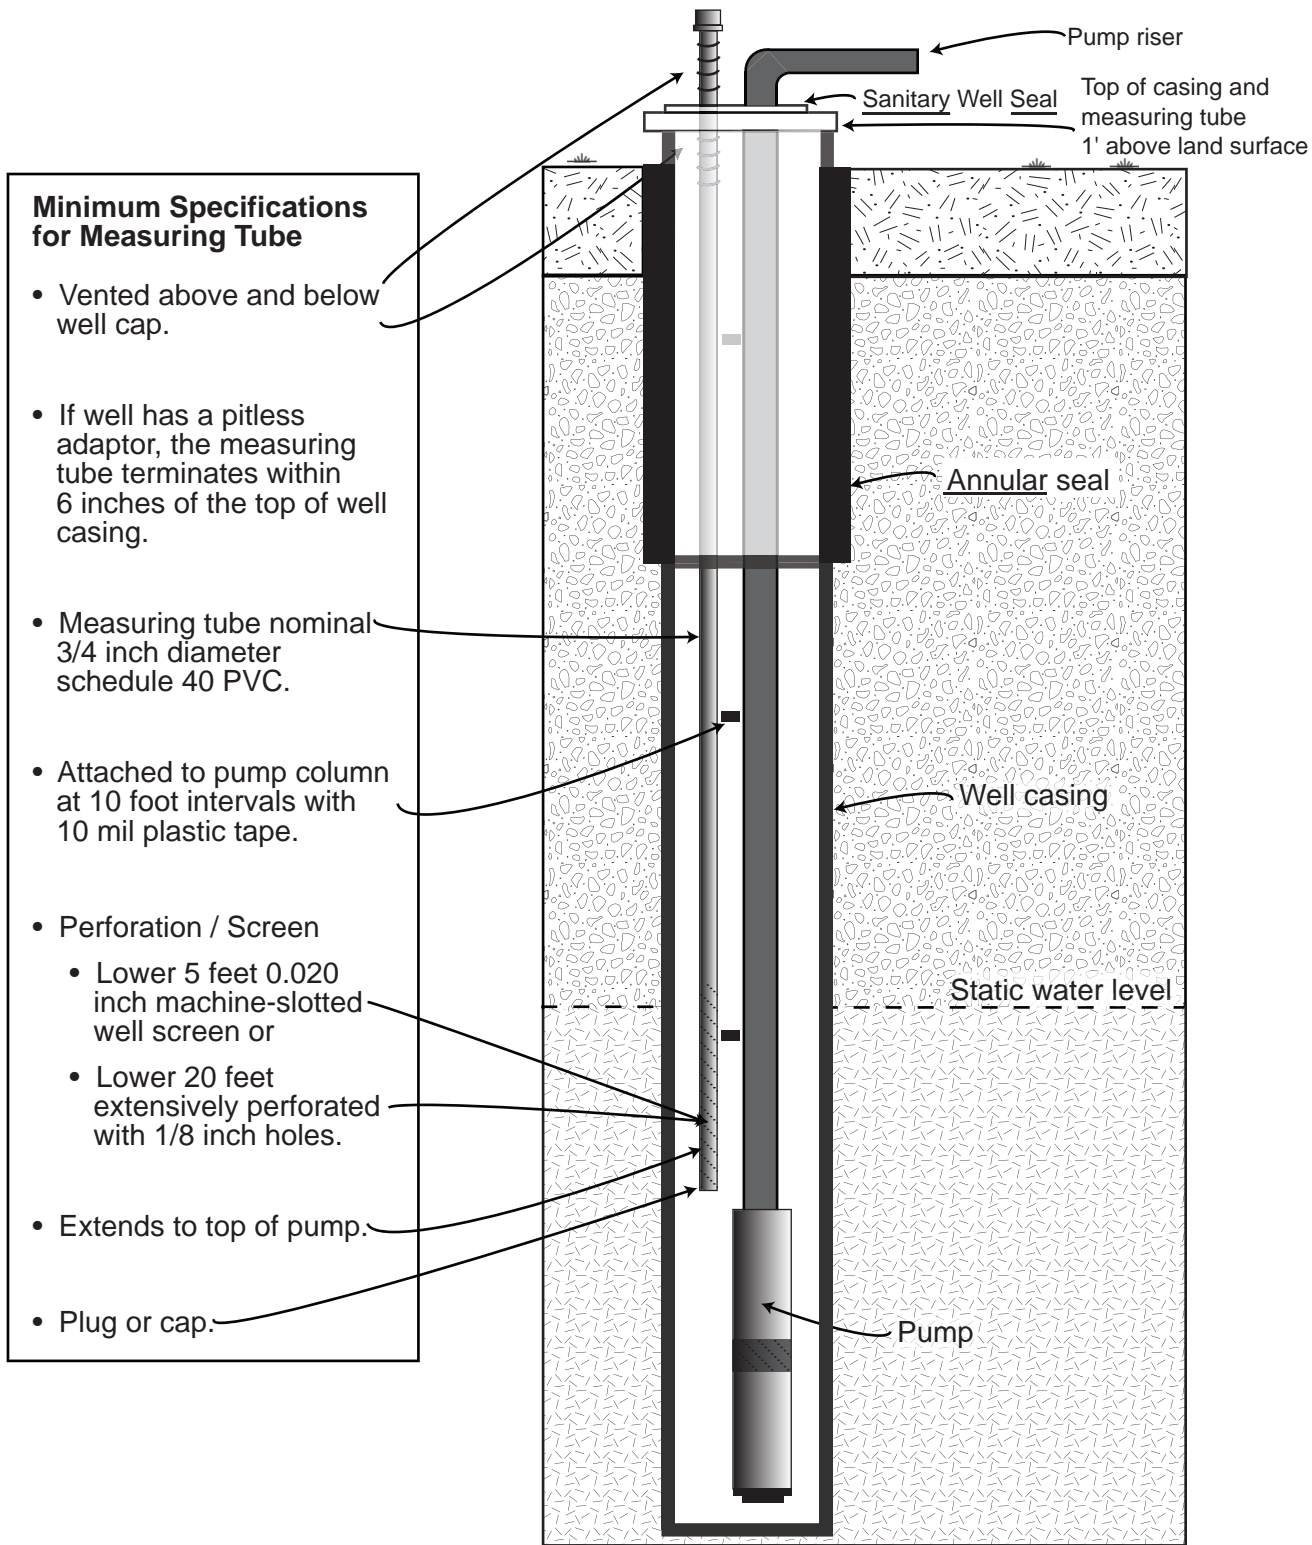

This diagram details the recommended minimum standards for a dedicated measuring tube. A measuring tube may be constructed in a manner that exceeds these standards without prior Department approval. The dedicated measuring tube shall not be reduced in size over the length of the pipe and shall remain free from wires or any other obstruction.

Bold text is proposed new language that was proposed in the hearing draft rules.

Bold and underlined text are proposed changes to the hearing draft rules.