


Backflow Prevention Device

Figure 215-1

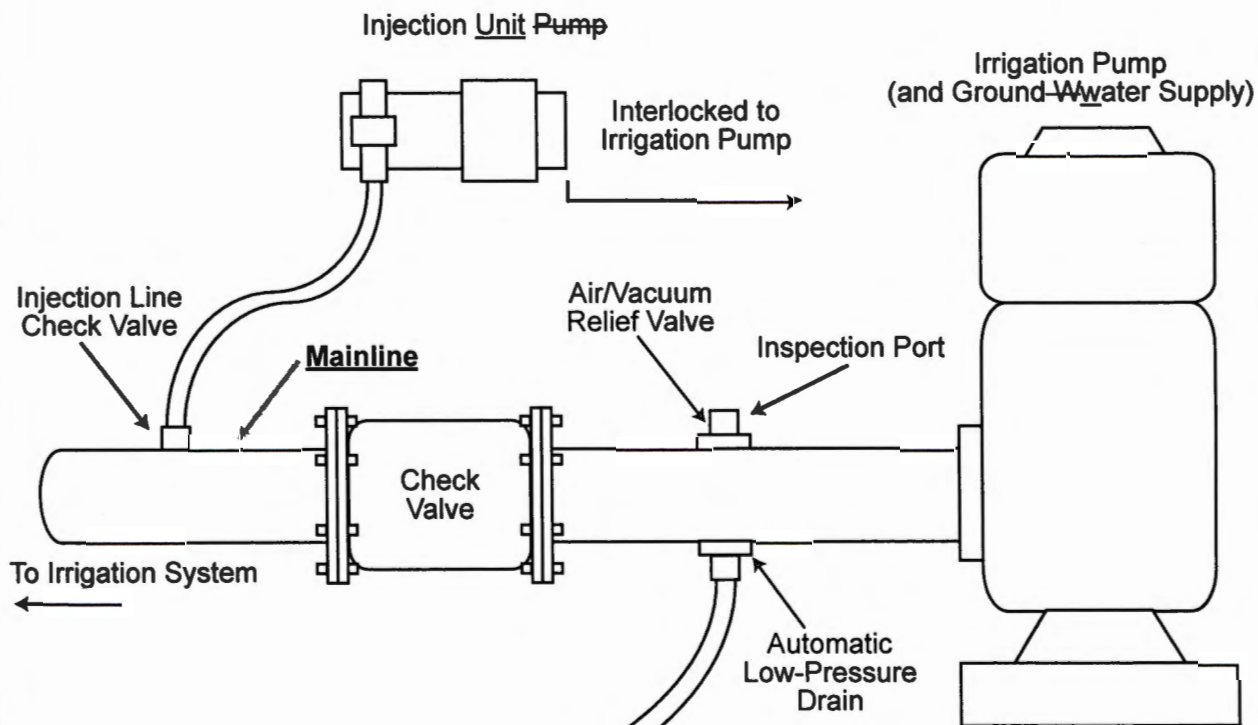


- Discharge solution a minimum of 20 feet a distance of at least 20 feet away and down gradient slope from wellwater source
- Maintain an air gap between end of discharge pipe and the discharged solution

Backflow prevention device using check valve with vacuum relief and low pressure drain.

Backflow Prevention Device

Figure 215-2

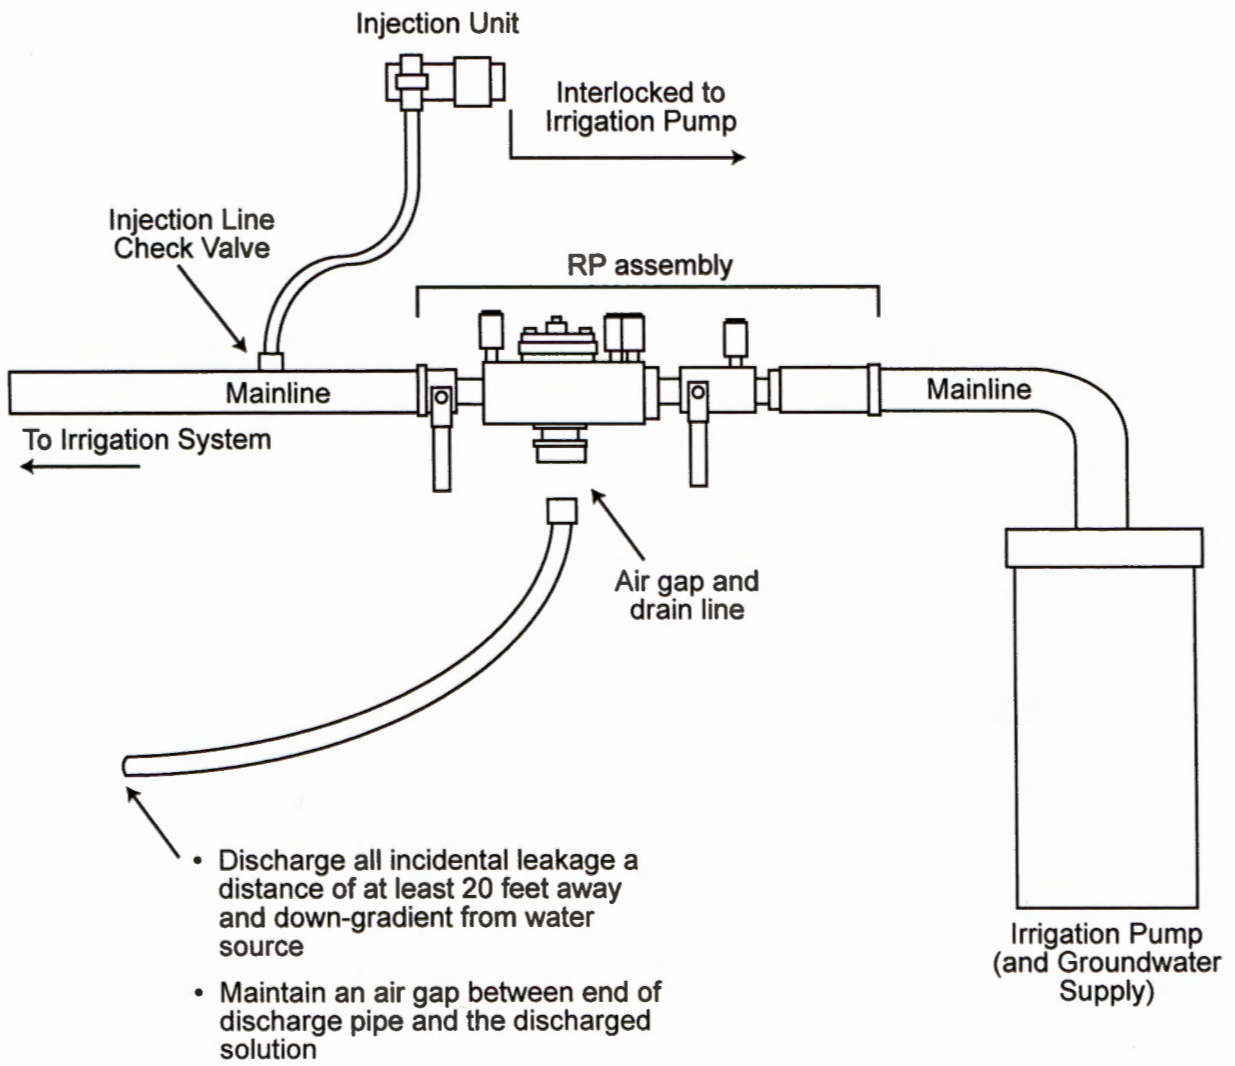

Backflow prevention device using a reduced pressure principle backflow prevention assembly (RP).