

STATE ENGINEER
Salem, Oregon

Baker
1017

Well Record

STATE WELL NO. 9/40-7R(1)
COUNTY Baker
APPLICATION NO. _____

OWNER: Arthur S. Boyd


MAILING ADDRESS: _____

LOCATION OF WELL: Owner's No. _____

CITY AND STATE: _____

SE 1/4 SE 1/4 Sec. 7 T. 9 ~~N.~~ 40 E. W., W.M.

Bearing and distance from section or subdivision corner _____

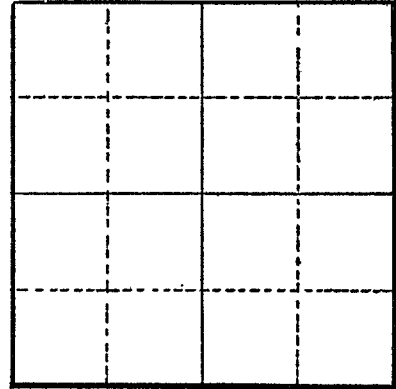

Section _____

Altitude at well 3,415

TYPE OF WELL: dug & drilled Date Constructed _____

Depth drilled 50 ft. Depth cased 50 ft.

CASING RECORD: 18 inches, 50 ft.

FINISH: _____

AQUIFERS: / Sand, gravel, and boulders from 50 ft. to 70 ft.

WATER LEVEL: 21.08 feet below land surface, Apr. 18, 1949

PUMPING EQUIPMENT: Type turbine H.P. _____
Capacity 1000 G.P.M.

WELL TESTS:
Drawdown _____ ft. after _____ hours _____ G.P.M.
Drawdown _____ ft. after _____ hours _____ G.P.M.

USE OF WATER irrigation Temp. _____ °F., 19____

SOURCE OF INFORMATION USGS

DRILLER or DIGGER _____

ADDITIONAL DATA:

Log Water Level Measurements _____ Chemical Analysis _____ Aquifer Test _____

REMARKS:

Owner reports well will yield at capacity for about a week, then drops off.

