

STATE ENGINEER  
Salem, Oregon

*Baker*  
*1018*

# Well Record

STATE WELL NO. 9/40-7R(2)  
COUNTY Baker  
APPLICATION NO. U-53

OWNER: Nels P. Pederson

MAILING  
ADDRESS:


LOCATION OF WELL: Owner's No. \_\_\_\_\_

CITY AND  
STATE:

Baker, Oregon

SE 1/4 SE 1/4 Sec. 7 T. 9 N. S., R. 40 E. W., W.M.

Bearing and distance from section or subdivision  
corner \_\_\_\_\_

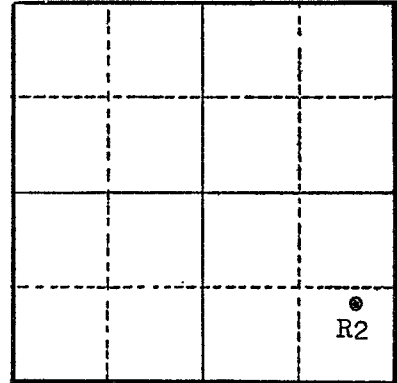

Section 7

Altitude at well \_\_\_\_\_

TYPE OF WELL: Dg. Dr. Date Constructed \_\_\_\_\_

Depth drilled 365 Depth cased \_\_\_\_\_

### CASING RECORD:

Dug 32', drilled to 365'  
8-inch casing

### FINISH:

Casing perforated from 18' to bottom

### AQUIFERS:

### WATER LEVEL:

16.84' below land surface, May 12, 1949

PUMPING EQUIPMENT: Type Turbine

H.P. \_\_\_\_\_

Capacity \_\_\_\_\_ G.P.M.

### WELL TESTS:

Drawdown \_\_\_\_\_ ft. after \_\_\_\_\_ hours \_\_\_\_\_ G.P.M.

Drawdown \_\_\_\_\_ ft. after \_\_\_\_\_ hours \_\_\_\_\_ G.P.M.

USE OF WATER \_\_\_\_\_ Temp. \_\_\_\_\_ °F., 19\_\_\_\_

SOURCE OF INFORMATION \_\_\_\_\_

DRILLER or DIGGER \_\_\_\_\_

### ADDITIONAL DATA:

Log \_\_\_\_\_ Water Level Measurements  Chemical Analysis \_\_\_\_\_ Aquifer Test \_\_\_\_\_

### REMARKS:

Hardness 110 ppm  
Chloride 15

