

STATE ENGINEER
Salem, Oregon

Baker
107

Well Record


STATE WELL NO. 7/39-28G(3)
COUNTY Baker
APPLICATION NO. _____

OWNER: T.R. O'Dell MAILING ADDRESS: _____

LOCATION OF WELL: Owner's No. _____ CITY AND STATE: _____

SW 1/4 NE 1/4 Sec. 28 T. 7 N S., R. 39 E W., W.M.

Bearing and distance from section or subdivision corner _____

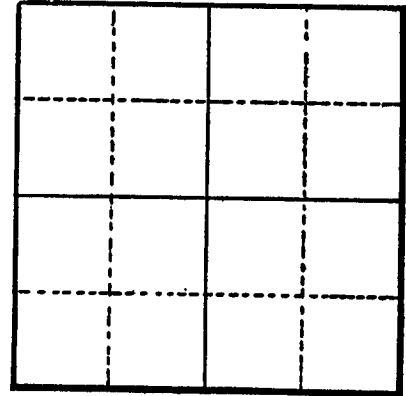

Section _____

Altitude at well 3,311

TYPE OF WELL: Dug Date Constructed _____

Depth drilled 40 ft. Depth cased _____

CASING RECORD: 60 inches.

FINISH: _____

AQUIFERS: _____

WATER LEVEL: _____

July 2, 1949

PUMPING EQUIPMENT: Type Centrifugal H.P. _____
Capacity 400 G.P.M.

WELL TESTS:

Drawdown _____ ft. after _____ hours _____ G.P.M.

Drawdown _____ ft. after _____ hours _____ G.P.M.

USE OF WATER Public service Temp. _____ °F. _____, 19____

SOURCE OF INFORMATION USGS

DRILLER or DIGGER _____

ADDITIONAL DATA:

Log _____ Water Level Measurements _____ Chemical Analysis _____ Aquifer Test _____

REMARKS: Used to dilute hot water for swimming pool.