

#3

BAKE 109 BAKE 109

STATE ENGINEER  
Salem, Oregon

# Well Record


STATE WELL NO. 7/39-28M(1)  
COUNTY BAKER  
APPLICATION NO. U-681

OWNER: MARTHA TRAVERSO ET AL MAILING ADDRESS: BAKER, ORE

LOCATION OF WELL: Owner's No. CITY AND STATE:

NW 1/4 SW 1/4 Sec. 28 T. 7 N. S., R. 39 E. W.M.

Bearing and distance from section or subdivision corner

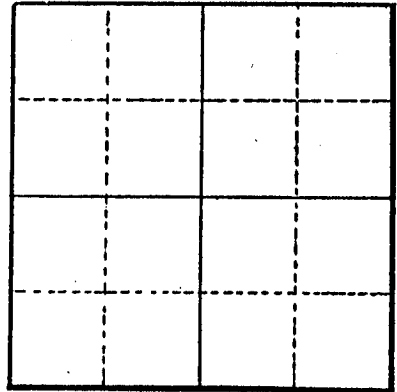

Section 28

Altitude at well

TYPE OF WELL: DRILLED Date Constructed

Depth drilled 316 Depth cased

### CASING RECORD:

16 INCH

### FINISH:

### AQUIFERS:

### WATER LEVEL:

10.99 (2-6-63)

PUMPING EQUIPMENT: Type H.P.  
Capacity 1200 G.P.M.

### WELL TESTS:

Drawdown ft. after hours G.P.M.  
Drawdown ft. after hours G.P.M.

USE OF WATER IRRIGATION Temp. °F. 19

SOURCE OF INFORMATION PERM. U-636

DRILLER or DIGGER

ADDITIONAL DATA:  
Log NA Water Level Measurements ✓ Chemical Analysis Aquifer Test

### REMARKS:

**BAKE 109**

For Official Use Only by The Oregon Water Resources Department:

Received Date: \_\_\_\_\_

County Well Log ID #

Well Identification Tag #

BAKE 109

L 95138

**APPLICATION FOR WELL IDENTIFICATION TAG**

**LANDOWNER INFORMATION**

Name: MARTHA TRAVERSO

Mailing Address: \_\_\_\_\_

City: Baker City State: OREGON Zip: 97814

Return Well Tag to (if different than mailing address): unknown

**WELL LOCATION INFORMATION**

County: Baker Township: 75 North or South (circle one) Range: 39 E East or West (circle one),

Section: 28 NW 1/4 SW 1/4 Tax Lot #: \_\_\_\_\_

Lat 44.92575 Long -117.94707 EPA 15.3

Street Address of Well (if different than mailing address): \_\_\_\_\_

**WELL INFORMATION (Do Not Complete If Well Report is Attached)**

Type of Well (i.e. domestic, irrigation, etc): \_\_\_\_\_ Date Well Constructed: \_\_\_\_\_

Well Constructor/Company: \_\_\_\_\_

Well Depth (in feet): \_\_\_\_\_ Diameter of Well Casing (in inches): \_\_\_\_\_

Landowner Who Had Well Constructed or Previous Owner at the Time Well was Constructed (if known): \_\_\_\_\_

**RECEIVED**

FEB 02 2011

WATER RESOURCES DEPT  
SALEM, OREGON

Other Information: state observation well

tagged by East Region well inspector Bob Maynard

Return to: Oregon Water Resources Department, Janet Halladey, 725 Summer St. NE, Suite A, Salem, OR 97301-1271, (503) 986-0854 or fax to 503-986-0902

App for tag