

STATE ENGINEER
Salem, Oregon

Baker
1002

Well Record

STATE WELL NO. 9/40-16H(1)
COUNTY Baker
APPLICATION NO. _____

OWNER: Baker Packing Co.


MAILING ADDRESS: _____

LOCATION OF WELL: Owner's No. _____

CITY AND STATE: _____

SE 1/4 NE 1/4 Sec. 16 T. 9 S., R. 40 W. W.M.

Bearing and distance from section or subdivision corner _____

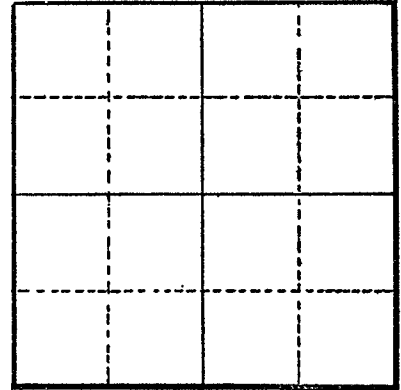

Section _____

Altitude at well 3.421

TYPE OF WELL: drilled Date Constructed _____

Depth drilled 600 Depth cased _____

CASING RECORD: 8 inches

FINISH: _____

AQUIFERS: _____

WATER LEVEL: Flowing, April 13, 1949

PUMPING EQUIPMENT: Type _____ H.P. _____
Capacity _____ G.P.M.

WELL TESTS:
Drawdown _____ ft. after _____ hours _____ G.P.M.
Drawdown _____ ft. after _____ hours _____ G.P.M.

USE OF WATER stock Temp. _____ °F., 19____

SOURCE OF INFORMATION USGS

DRILLER or DIGGER _____

ADDITIONAL DATA:
Log _____ Water Level Measurements _____ Chemical Analysis x Aquifer Test _____

REMARKS: Hardness 40 ppm, chloride 11 ppm. Flow estimated at 2 gallons per min. water has slight oror of hydrogen sulfide gas; temp. of 79°F.