

STATE ENGINEER  
Salem, Oregon

*Bake 1164*

# Well Record

STATE WELL NO. 9/40-28D(1)  
COUNTY Baker  
APPLICATION NO. \_\_\_\_\_

OWNER: Calif. Pacific Utility Co.


MAILING ADDRESS: \_\_\_\_\_

LOCATION OF WELL: Owner's No. \_\_\_\_\_

CITY AND STATE: \_\_\_\_\_

NW 1/4 NW 1/4 Sec. 28 T. 9 S., R. 40 W., W.M.

Bearing and distance from section or subdivision corner \_\_\_\_\_

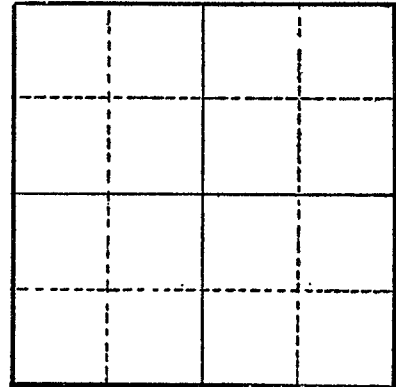

Section \_\_\_\_\_

Altitude at well 3,479

TYPE OF WELL: drilled Date Constructed \_\_\_\_\_

Depth drilled 578 Depth cased 100+

CASING RECORD: 15 inches

FINISH: \_\_\_\_\_

AQUIFERS: Basalt

WATER LEVEL: 39.3 feet below land surface, March 15, 1949

PUMPING EQUIPMENT: Type turbine H.P. \_\_\_\_\_  
Capacity 1050 G.P.M.

WELL TESTS:  
Drawdown \_\_\_\_\_ ft. after \_\_\_\_\_ hours \_\_\_\_\_ G.P.M.  
Drawdown \_\_\_\_\_ ft. after \_\_\_\_\_ hours \_\_\_\_\_ G.P.M.

USE OF WATER Industrial Temp. \_\_\_\_\_ °F., 19\_\_\_\_

SOURCE OF INFORMATION USGS

DRILLER or DIGGER \_\_\_\_\_

ADDITIONAL DATA:

Log  Water Level Measurements \_\_\_\_\_ Chemical Analysis \_\_\_\_\_ Aquifer Test \_\_\_\_\_

REMARKS:

Hardness 90 ppm, chloride 9 ppm. Temp. of water 58° F.

