

STATE ENGINEER
Salem, Oregon

*Baker
125*

Well Record


STATE WELL NO. 7/39/33L(1)
COUNTY Baker
APPLICATION NO. GR-658

OWNER: City of Haines MAILING ADDRESS: _____

LOCATION OF WELL: Owner's No. 1 CITY AND STATE: Haines, Oregon

NE 1/4 SW 1/4 Sec. 33 T. 7 S., R. 39 W., W.M.

Bearing and distance from section or subdivision
corner 200' west and 100' south from center
of section 33.

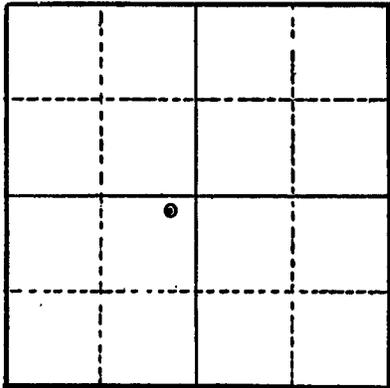

Section 33

Altitude at well 3333' Interpolated

TYPE OF WELL: Drilled Date Constructed 1910

Depth drilled 160 Depth cased 160'

CASING RECORD:
6-inch

FINISH:

AQUIFERS:

WATER LEVEL:
50 feet

PUMPING EQUIPMENT: Type Fairbanks Morse H.P. 15
Capacity 2000 G.P.M.

WELL TESTS:
Drawdown ft. after hours G.P.M.
Drawdown ft. after hours G.P.M.

USE OF WATER municipal Temp. °F., 19.....

SOURCE OF INFORMATION GR-658

DRILLER or DIGGER _____

ADDITIONAL DATA:
Log Water Level Measurements Chemical Analysis Aquifer Test

REMARKS: