

#4
STATE ENGINEER
Salem, Oregon

Well Record

STATE WELL NO. 8/39-22F(1)
COUNTY Baker
APPLICATION NO.

OWNER: Baker County


MAILING
ADDRESS:

LOCATION OF WELL: Owner's No.

CITY AND
STATE:

SE 1/4 NW 1/4 Sec. 22 T. 8 N. S., R. 39 W., W.M.

Bearing and distance from section or subdivision
corner

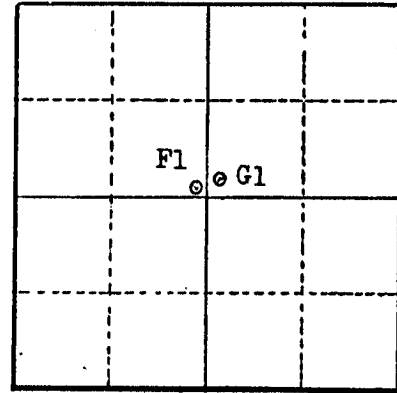

Section 22

Altitude at well 3375.78

TYPE OF WELL: Dug Date Constructed

Depth drilled 11 Depth cased

CASING RECORD:

Cribbed with wood to 9'
12-inch perforated steel casing set from 7 to 11'

FINISH:

AQUIFERS:

Sand & gravel

WATER LEVEL:

PUMPING EQUIPMENT: Type H.P.
Capacity G.P.M.

WELL TESTS:

Drawdown ft. after hours G.P.M.

Drawdown ft. after hours G.P.M.

USE OF WATER Temp. °F., 19

SOURCE OF INFORMATION

DRILLER or DIGGER

ADDITIONAL DATA:

Log Water Level Measurements X Chemical Analysis Aquifer Test

REMARKS:

Constructed by U.S.G.S. as an observation well.