## STATE OF OREGON

Address 44941 SCHOOLHOUSE RD

Material

X Rotary Air Rotary Mud

Reverse Rotary Other

Industrial/ Commericial

Thermal Injection

BORE HOLE

From

0

100

400

How was seal placed:

Filter pack from \_

Explosives used:

(6) CASING/LINER Casing Liner

Shoe

Perf/

Perf

Perf

Screen Liner

Pump

Temperature 55

rom

Casing

Casing

Yield gal/min

600

Water quality concerns?

Temp casing X Yes

(•)

Proposed Amount

X Other POURED DRY Backfill placed from \_

(5) BORE HOLE CONSTRUCTION

Depth of Completed Well 610.00 ft.

To

100

400

610

Yes

Dia

12

8

Inside

(7) PERFORATIONS/SCREENS

Casing/ Screen

Screens Type

Dia

12

8

(1) LAND OWNER

(2) TYPE OF WORK

(4) PROPOSED USE

(2a) **PRE-ALTERATION** 

Dia

First Name GARY

City HAINES

Casing:

Seal: (3) DRILL METHOD

Dia

18

14

10

Company

#### WATER SUPPLY WELL REPORT

(as required by ORS 537.765 & OAR 690-205-0210)

From

X New Well

Alteration (complete 2a & 10)

Cement

Method

ft. to \_

Type\_

+

X

Outside

Perforations Method AIR KNIFE

From

255

390

(8) WELL TESTS: Minimum testing time is 1 hour

Bailer

Drawdown

Dia 16

ft. to

(5a) ABANDONMENT USING UNHYDRATED BENTONITE

From

2

390

X Other

То

390

610

• Air

°F Lab analysis Yes By

Drill stem/Pump depth

Yes (describe below) TDS amount

Description

600

Material

Bentonite Chips

A

From

From

0

28

XC

B

ft. Material

To

400

610

From 0

Scrn/slot

width

.125

.125

ft. Material

Amount

Actual Amount

Gauge

0.25

0.25

Location of shoe(s)

Material

Slot

length

1

1

To

28

100

D

Size

Stl Plstc

•

To 100

# of

slots

6500

6300

Flowing Artesian
Ar

Duration (hr)

Amount

2

Amt

35 S

70

lbs

S

Wld Thrd

Tele/

pipe size

4/22/2014

4/24/2014

## **BAKE 52346**

OST WELL I.D. LABEL# L 113683 157016 START CAF

RD #	1022785	
OG #		

Page 1 of 2

34

34

<b>KEFUKI</b>		011		" 1022	/85			
& OAR 690-205-0210) 5	5/28/2014	ORIG	INAL LOG	#				
Owner Well I.D Last Name POINTER		ON OF W	VELL (lega	l descri	ption)			
RD StateORZip _97833	County <u>BAKER</u> Sec <u>26 N</u>				ange <u>38.00</u> Tax Lot <u>7</u> :		E/W WN	М
State OR Zip   New Well Deepening Conversion   1 (complete 2a & 10) Abandonment(complete	Lat	'	" or		Lot		DMS or DD DMS or DD	
To Gauge Stl Plstc Wld Thrd		eet address of OF 13997 CA	Ċ	Nearest ac R LN. HA		<u> </u>		]
	(10) STATIC	CWATER		ate SV	VL(psi) +		SWL(ft)	-
d Cable Auger Cable Mud	Existing We Completed		ation 5/9/201	4			34	
Domestic X Irrigation Community Livestock Dewatering	WATER BEARI		ng Artesian? Depth		y Hole?	62.	00	
Other	SWL Date	From	То	Est Flow	SWL(psi)	+	SWL(ft)	
UCTION Special Standard (Attach	1012011	62	71	5			34	
510.00 ft. SEAL s	acks/ 4/18/2014 4/21/2014	194 255	233 268	75 80			34	

(11)	WELL LOG	Ground Elevation

281

347

347

406

300

100

From	То
0	3
3	54
54	62
62	71
71	194
194	233
233	255
255	268
268	281
281	347
347	374
374	390
390	416
416	468
468	485
485	610
	$\begin{array}{c c} 0\\ \hline \\ 3\\ \hline \\ 54\\ \hline \\ 62\\ \hline \\ 71\\ \hline \\ 194\\ \hline \\ 233\\ \hline \\ 255\\ \hline \\ 268\\ \hline \\ 281\\ \hline \\ 347\\ \hline \\ 374\\ \hline \\ 390\\ \hline \\ 416\\ \hline \\ 468\\ \end{array}$

Date Started4/14/2014 Complete 5/9/2014

(unbonded) Water Well Constructor Certification

I certify that the work I performed on the construction, deepening, alteration, or abandonment of this well is in compliance with Oregon water supply well construction standards. Materials used and information reported above are true to the best of my knowledge and belief.

Date

Date 5/28/2014

License Number

Signed

#### (bonded) Water Well Constructor Certification

I accept responsibility for the construction, deepening, alteration, or abandonment work performed on this well during the construction dates reported above. All work performed during this time is in compliance with Oregon water supply well construction standards. This report is true to the best of my knowledge and belief.

License Number 1775

Signed JASON ACQUISTAPACE (E-filed)

Contact Info (optional)


**ORIGINAL - WATER RESOURCES DEPARTMENT** 

Units

THIS REPORT MUST BE SUBMITTED TO THE WATER RESOURCES DEPARTMENT WITHIN 30 DAYS OF COMPLETION OF WORK Form Version:

## WATER SUPPLY WELL REPORT -

continuation page

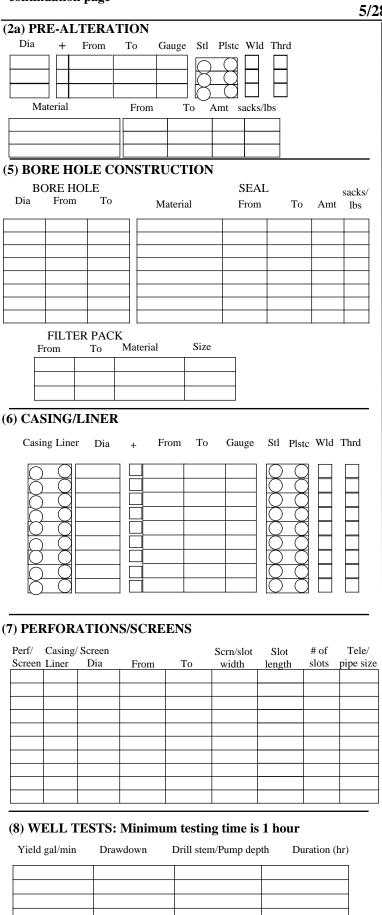

# BAKE 52346 WELL I.D. LABEL# L 113683 157016

## START CARD # 1022785 ORIGINAL LOG #

Page 2 of 2

5/28/2014

## Water Quality Concerns

From	То	Description	Amount	Units

### (10) STATIC WATER LEVEL

SWL Date	From	То	Est Flow	SWL(psi)	+	SWL(ft)
5/2/2014	416	468	100			34
5/5/2014	485	610	150			34

## (11) WELL LOG

Material	From	То

### **Comments/Remarks**



**Oregon Water Resources Department** 725 Summer Street NE, Suite A Salem Oregon 97301 (503) 986-0900 WATER RESOURCES DEPARTMENT WWW.oregon.gov/owrd

# **Application for** Well ID Number

	RECEIVED
Do not complete if the well already has a Well Identification Number.	JAN 7 2025
I. OWNER INFORMATION	OWRD
Current Owner Name (please print): GARY POINTER	
Mailing Address: 13541 LITTLE MUDDY CREEK LN	······································
City, State, Zip: HAINES, OR, 97833	<u> </u>
Mail Well ID to: SAME AS ABOVE In Care Of (C/O)	
Name & Address:	
City, State, Zip:	
II. WELL LOCATION INFORMATION (Please fill out as completely as possible)	
Township:   7 S   (North / South)   Range:   38 E   (East / West)   Section:   26   NE     Tax Lot (usually last 3-5 numbers of Tax Map #):   7500 (on lot line)   County   BAKER     GPS Coordinates:   44.924228°, -118.023630°   100 Fr herize	1/4 of the SW 1/4
Tax Lot (usually last 3-5 numbers of Tax Map #): 7500 (on lot line) County BAKER	
GPS Coordinates: 44.924228°, -118.023630°	ntal error allowance.
Street Address of Well, City: 13997 CALLEY FISHER LN (next to), HAINES, OR 97833	
If the property had a different street address in the past:	
III. GENERAL WELL INFORMATION (Please fill out as completely as possible, AND attach copy of Well Rep	oort, if available)
Use of Well (domestic, irrigation, commercial, industrial, monitoring): IRRIGATION	
Date Well Constructed (or property built): 5-9-2014 Total Well Depth: 610'	ing Diameter: 12", 8"
Owner at time the well was constructed (if known): GARY POINTER Well Report # (if known)	n): BAKE 52346 & 52597
Other Information: WELL WAS ORIGINALLY ASSIGNED WELL TAG L-113683 WHICH WA	S NEVER INSTALLED
SUBMITTED BY (please print): PAUL GARVIN	
PHONE: 503-347-7188 EMAIL &/or FAX: GARVIN.HYDROGEO@	GMAIL.COM
To send the completed application, you may MAIL it to: Oregon Water Resources Dept. 725 Summer St NE, Su Or EMAIL the completed PDF form to: Ladeena.K.Ashley@water.oregon.gov, or FAX it to: (503) 986-0902.	ite A, Salem, Oregon 97301.
	CEMENT WELL ID*
For Official Use Only by the Oregon Water Resources Department:	
Received Date: Well Report Number:	Well Identification #:
<u>1-7-2025</u> <u>BAKE 52346 (ORIG)</u>	L-157016
BAKE 52597 (DEEP)	

Last Update: 5-10-23