

#13
STATE ENGINEER
Salem, Oregon

Well Record

STATE WELL NO. 8/40-19D(1)
COUNTY Umatilla Bake
APPLICATION NO. 7

OWNER: Baker County

MAILING
ADDRESS:

LOCATION OF WELL: Owner's No.

CITY AND
STATE:


NW NW 19 8 N. 40 E.
1/4 1/4 Sec. T. S. R. W., W.M.

Bearing and distance from section or subdivision
corner

Altitude at well 3,342

TYPE OF WELL: Dug & Bored Date Constructed

Depth drilled 8.2 ft. Depth cased 13 ft.

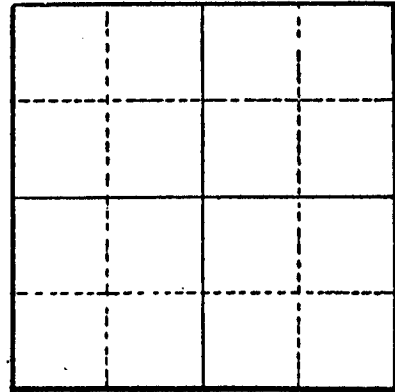

Section

CASING RECORD: 18 inches, 13 ft.

FINISH:

AQUIFERS: Sand and gravel from 2 ft. to 12 ft.

WATER LEVEL:

2.69 feet below land surface, June 11, 1936

2.24 feet below land surface, March 31, 1949

PUMPING EQUIPMENT: Type H.P.
Capacity G.P.M.

WELL TESTS:

Drawdown ft. after hours G.P.M.

Drawdown ft. after hours G.P.M.

USE OF WATER Observance Temp. °F., 19.....

SOURCE OF INFORMATION uses

DRILLER or DIGGER

ADDITIONAL DATA:

Log x Water Level Measurements Chemical Analysis Aquifer Test

REMARKS: Hardness 10ppm, chloride 3ppm.