

#14
STATE ENGINEER
Salem, Oregon

Well Record

STATE WELL NO. 8/40-23A(1)
COUNTY Baker
APPLICATION NO.

OWNER: Baker County

MAILING
ADDRESS:

LOCATION OF WELL: Owner's No.

CITY AND
STATE:

NE NE 23 8 N. 40 E.
1/4 1/4 Sec. T. S. R. W., W.M.


Bearing and distance from section or subdivision

corner

Altitude at well 3,349

TYPE OF WELL: Dug & Bored
Date Constructed

Depth drilled 9 ft. Depth cased 14 ft.

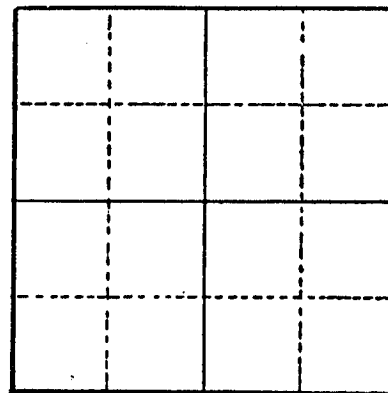

Section

CASING RECORD: 18 inches, 14 ft.

FINISH:

AQUIFERS: Fine sand and fine gravel from 6 ft. to 15 ft.

WATER LEVEL:

4.54 feet below land surface, Junell, 1936

PUMPING EQUIPMENT: Type H.P.
Capacity G.P.M.

WELL TESTS:

Drawdown ft. after hours G.P.M.

Drawdown ft. after hours G.P.M.

Observation

USE OF WATER Temp. °F., 19.....

SOURCE OF INFORMATION USGS

DRILLER or DIGGER

ADDITIONAL DATA:

Log ☒ Water Level Measurements ☒ Chemical Analysis Aquifer Test

REMARKS: