

STATE ENGINEER
Salem, Oregon

BAKER
79

Well Record

STATE WELL NO. 1/39-3B(1)
COUNTY BAKER
APPLICATION NO.

OWNER: L. H. WILLIAMS


MAILING ADDRESS:

LOCATION OF WELL: Owner's No.

CITY AND STATE:

NW 1/4 NE 1/4 Sec. 3 T. 7 N. S., R. 39 E. W.M.

Bearing and distance from section or subdivision corner

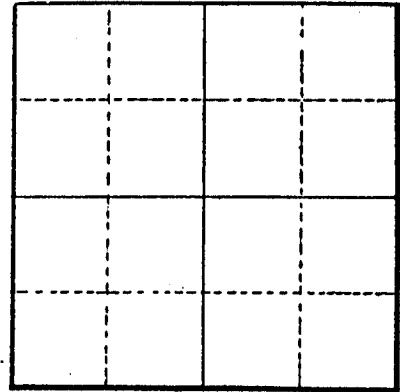

Section 3

Altitude at well

TYPE OF WELL: DRILLED Date Constructed

Depth drilled 237 Depth cased

CASING RECORD:

FINISH:

AQUIFERS:

WATER LEVEL:

27.04 (5-8-63)

PUMPING EQUIPMENT: Type NONE H.P.
Capacity G.P.M.

WELL TESTS:

Drawdown ft. after hours G.P.M.
Drawdown ft. after hours G.P.M.

USE OF WATER NONE Temp. °F., 19

SOURCE OF INFORMATION L. H. WILLIAMS

DRILLER or DIGGER

ADDITIONAL DATA:

Log NA Water Level Measurements ✓ Chemical Analysis Aquifer Test

REMARKS: