

STATE ENGINEER  
Salem, Oregon

*Baker 973*

# Well Record

STATE WELL NO. 9/40-3N(2)  
COUNTY Baker  
APPLICATION NO. U-23

OWNER: Mrs. Edith H. Miller


MAILING ADDRESS: \_\_\_\_\_

LOCATION OF WELL: Owner's No. \_\_\_\_\_

CITY AND STATE: Baker, Oregon

SW  $\frac{1}{4}$  SW  $\frac{1}{4}$  Sec. 3 T. 9 <sup>N.</sup>S., R. 40 <sup>E.</sup>W., W.M.

Bearing and distance from section or subdivision corner \_\_\_\_\_

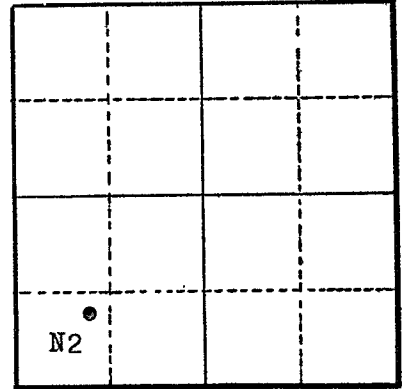

Section 3

Altitude at well \_\_\_\_\_

TYPE OF WELL: Dug Date Constructed \_\_\_\_\_

Depth drilled 16 Depth cased \_\_\_\_\_

CASING RECORD:

FINISH:

AQUIFERS:

WATER LEVEL:

PUMPING EQUIPMENT: Type \_\_\_\_\_ H.P. \_\_\_\_\_  
Capacity \_\_\_\_\_ G.P.M.

WELL TESTS:  
Drawdown \_\_\_\_\_ ft. after \_\_\_\_\_ hours \_\_\_\_\_ G.P.M.  
Drawdown \_\_\_\_\_ ft. after \_\_\_\_\_ hours \_\_\_\_\_ G.P.M.

USE OF WATER Irrigation Temp. \_\_\_\_\_ °F. \_\_\_\_\_, 19

SOURCE OF INFORMATION U-23

DRILLER or DIGGER \_\_\_\_\_

ADDITIONAL DATA:  
Log \_\_\_\_\_ Water Level Measurements \_\_\_\_\_ Chemical Analysis \_\_\_\_\_ Aquifer Test \_\_\_\_\_

REMARKS: