

STATE ENGINEER
Salem, Oregon

Baker
984

Well Record

STATE WELL NO. 9/40-4Q(1)
COUNTY Baker
APPLICATION NO. _____

OWNER: Harold Peters


MAILING ADDRESS: _____

LOCATION OF WELL: Owner's No. _____

CITY AND STATE: _____

SW SE 1/4 Sec. 4 T. 9 N. 40 E. S., R. 40 W., W.M.

Bearing and distance from section or subdivision corner _____

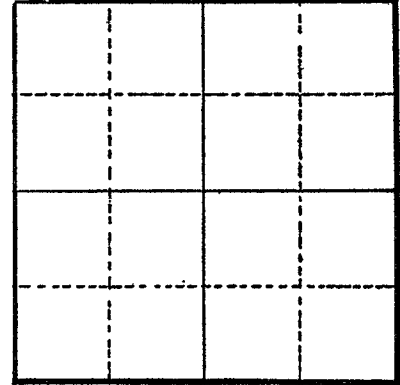

Section _____

Altitude at well 3,399

TYPE OF WELL: dug & driven Date Constructed _____

Depth drilled 26.4 ft. Depth cased _____

CASING RECORD: 2 1/2 inches

FINISH: _____

AQUIFERS: _____

WATER LEVEL: 13.41 feet below land surface, Mar. 9, 1949

PUMPING EQUIPMENT: Type plunger H.P. _____
Capacity _____ G.P.M.

WELL TESTS:
Drawdown _____ ft. after _____ hours _____ G.P.M.
Drawdown _____ ft. after _____ hours _____ G.P.M.

USE OF WATER stock & irrigation Temp. _____ °F., 19____

SOURCE OF INFORMATION USGS

DRILLER or DIGGER _____

ADDITIONAL DATA:

Log _____ Water Level Measurements _____ Chemical Analysis _____ Aquifer Test _____

REMARKS: Hardness 55ppm, chloride 6ppm.