


STATE OF OREGON WATER SUPPLY WELL REPORT (as required by ORS 537.765) (START CARD) #. Instructions for completing this report are on the last page of this form.

Address Chic Chicago	(1) OWNER: Well Number ///	(9) LOCATION OF		scription:		
Special Construction approach Yes (Effect Dober Yes	Name Harry MacCormock					
Casing	Address 6910 S. W. Plymouth DR		N_or Range	_54	L E of	W) WM.
20 NELL METHOD: Abandomment Alexandom Abandom Abandomment Alexandom Abandom	City Orugilis State OR Zip 9733:	Section 17	NW 1/4	nu	1/4	
New Well Desembring Albertition (repair/recoordition) Albandonment	(2) TYPE OF WORK		Lot Block	S	ubdivision	
Abandonment	Street Address of W		Samo		
Open Contest			(01 11011000 1101000)		*****	
Open Contest	Rotary Air Rotary Mud Cable Auger	(10) STATIC WATE	DIEVEL.		·····	<u> </u>
Monestic Community Industrial Irrigation Thermal Injection Livestock Other						625/29
Depth at which water was first found Depth at water was first found	-			are inch.	Date	· · · · · · · · · · · · · · · · · · ·
Special Construction approval Yes Xes Xe		(II) WATER BEAR	ING ZONES:			
Special Construction approved Yes No Depth of Completed Well Yes No Depth of Completed Well Yes No Type Amount SEAL Diameter From To Sacks of pounds Seal How was seal placed: Method A B C D B Backfill placed from ft. to ft. Size of gravel (6) CASING/INFR: From To Cauge Steel Plastic Welled Threaded Casing: G From To SWL Solve Seal Sea			٠	1 -		
Special Constitution approval Test Minimum testing time is 1 hour Prom		Depth at which water w	as first found	0		·
HOLE Blantety From To Material From To Seeks or pounds	Special Construction approval Yes No Depth of Completed Well 45 ft.					
Diameter Propp To Socies or pounds		From	То			SWL
Diameter From To Material From To Sacks or pounds	HOLE SEAL	120	121'	2 6%	in	60'
How was seal placed: Method A B B C D E	Diameter From To Material From To Sacks or pounds	190'	191'	7		60'
How was seal placed: Method A B B C D E	10 0 10 Cement 0 18 19 3005	224'	205			
Other Backfill placed from ft, to ft. Material Carwel placed from ft, to ft. Size of gravel (6) CASING/LINER: Diameter From To Gauge Steel Plastic Welded Threaded Casing	How was seal placed: Method A R D D	1 1	1771 .1			
Material From To SWL		Groun	d Elevation			70, t.
Casing:			• •		T ===	1 .
(6) CASING/LINER: Diameter From To Gauge Steet Plastic Welded Threaded Casing: Liner:			ial	From	<u> </u>	1
Diameter From To Gauge Steet Plastic Welded Threaded Casing:				0		0
Casing:					43	0
Liner:	Diameter From To Gauge Steel Plastic Welded Threaded			43	54	0
Liner:	Casing: 6 72 78 250 2	Brown	lav	54	67	0
Liner:		Weathers	& Sand sto	ne 67		0
Final location of shoe(s)				72		60'
Final location of shoe(s) PerFORATIONS/SCREENS:						
Final location of shoe(s) PerFORATIONS/SCREENS:	Liner: None					
Perforations Method NOV 29 1994 NOV 29 1994						-
Perforations Method Screens Type Material NOV 29 1994 Mode	Final location of shoe(s)		JEPENE TENE			
Perforations Method Screens Type Material Slot Size Number Diameter Size Casing Liner SAI FM OREGON	(7) PERFORATIONS/SCREENS:	2		y		
Sereens Type Material NOV 2-9 1934 MOV 2-9 1934						
Solid Size Number Diameter Size Casing Liner SAI FM OREGON			- NOV-2:9 199	4		
Sal FM OREGON	Slot	3147			 	
(8) WELL TESTS: Minimum testing time is 1 hour Pump	From To size Number Diameter size Casing Liner				 	<u> </u>
Completed Comp	None		<u>SALEM, OREGO</u>	N .		
Pump	(8) WELLTESTS: Minimum testing time is 1 hour	Date started ///	34/94 Com	pleted /	1/20-1	94
Pump	_				4	
Signed Depth Artesian Flow Found Signed Date Signed	Pump Bailer Air Artesian	Leggify that the work	I performed on the con	etmotion alter	ation or sh	andonment
Materials used and information reported above are true to the best of my knowledge and belief. WWC Number 4		of this well is in complia	nce with Oregon water	supply well con	nstruction s	tandards.
Temperature of water		Waterials used and inton	nation reported above a	ire true to the b	est of my k	nowledge
Temperature of water	1.111.	and tener.	^	1111110	. 14	· 11
Temperature of water		1/4	n mtc			- 1
Was a water analysis done? Yes By whom Did any strata contain water not suitable for intended use? Too little Salty Muddy Odor Colored Other Depth of strata: I accept responsibility for the construction, alteration, or abandonment work performed on this well during the construction dates reported above. All work performed during this time is in compliance with Oregon water supply well construction standards. This report is true to the best of my knowledge and belief. WWC Number 75/ Signed Date 1/13/4	Townseature of water Property Control of the Contro		UIVE		Date	
Did any strata contain water not suitable for intended use?	• • • • • • • • • • • • • • • • • • • •	1				
Salty Muddy Odor Colored Other — performed during this time is in compliance with Oregon water supply well construction standards. This report is true to the best of my knowledge and belief. WWC Number 75/ Signed Date 1/3/4		I accept responsibility	for the construction, al	teration, or aba	indonment	work
Depth of strata: Signed Donald Since to the best of my knowledge and belief. WWC Number 75/ Date 1//3/4	Did any strata contain water not suitable for intended use?	performed on this well d	aring the construction d	ates reported a	bove. All w	ork I
Depth of strata: WWC Number 75/ Signed Donald 1 prince Date 11/3/4	Salty Muddy Odor Colored Other	construction standards.	This report is true to the	best of my kno	owledge and	belief.
Signed Jonald Joven Date 11/3/4	Depth of strata:			WWC Nur	nber 📆	5/
	Yes come manage of report 1 . 12 .	Signed /)	00 11	,		
ORIGINAL & FIRST COPY-WATER RESOURCES DEPARTMENT SÉCOND COPY-CONSTRUCTOR THIRD COPY-CUSTOMER	ORIGINAL & FIRST COPY-WATER RESOURCES DEPARTMENT SE		TO THE TOTAL	CODY CY		774

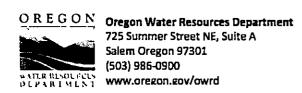

Application for Well ID Number

Do not complete if the well already has a Well Identification Number.

I. OWNER INFORMATION						
Current Owner Name (please print): Sunbow Farm LLC	· · · · · · · · · · · · · · · · · · ·					
Mailing Address: 6910 SW Plymouth Dr						
City, State, Zip: Corvallis OR 97333	RECEIVED					
Mail Well ID to: SAME AS ABOVE In Care Of (C/O)	RECEIVED					
	MAR 07 2022					
Name & Address:	·					
City, State, Zip:	OWRD					
II. WELL LOCATION INFORMATION (Please fill out as completely as possible)						
Township: 12S (North / South) Range: 5W (East / West) Section: 17 NW	/ 1/4 of the NW 1/4					
Tax Lot (usually last 3-5 numbers of Tax Map #): 600 County OR						
GPS Coordinates: N 44.53338, W 123.33299						
Street Address of Well, City: 6910 SW Plymouth Dr, Corvallis						
If the property had a different street address in the past:						
title property riad a different street address in the past.						
III. GENERAL WELL INFORMATION (Please fill out as completely as possible, AND attach copy of We	ell Report, if avoilable)					
Use of Well (domestic, irrigation, commercial, industrial, monitoring): Irrigation						
Date Well Constructed (or property built): 10/25/1994 Total Well Depth: 245' Casing Diameter: 6"						
Owner at time the well was constructed (if known): Harry MacCormack Well Report # (if						
Other Information:						
SUBMITTED BY (please print): Nathan Johnson						
PHONE: 971-409-8009 EMAIL &/or FAX: SUNDOWPRODUCE@per	ak.org					
To send the completed application, you may MAIL it to: Oregon Water Resources Dept. 725 Summer St N Or EMAIL the completed PDF form to: Ladeena.K.Ashley@water.oregon.gov, or FAX it to: (503) 986-0902						
For Official Use Only by the Oregon Water Resources Department:						
Received Date: Well Report Number:	Well Identification #:					
3-7-22 BENT 1510	L-146812					