

STATE ENGINEER
Salem, Oregon

*Bent
15248*

Well Record

STATE WELL NO. 10/3W-6C
COUNTY BENTON
APPLICATION NO. GR-2872

OWNER: W. R. Winn


MAILING ADDRESS: 220 Picardy Lane

LOCATION OF WELL: Owner's No. _____

CITY AND STATE: Albany, Oregon

NE 1/4 NW 1/4 Sec. 6 T. 10 N. S., R. 3 E. W., W.M.

Bearing and distance from section or subdivision corner 600' S. and 2871' W.

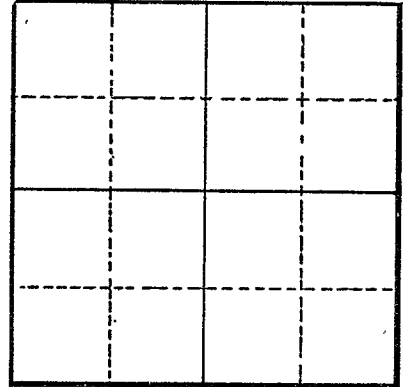

Section _____

Altitude at well _____

TYPE OF WELL: driven Date Constructed 1953

Depth drilled 33 Depth cased 33

CASING RECORD:

2-inch

FINISH:

AQUIFERS:

WATER LEVEL:

PUMPING EQUIPMENT: Type McDonald Centrifugal H.P. 1/2
Capacity 10 G.P.M.

WELL TESTS:

Drawdown _____ ft. after _____ hours Pumping 10 G.P.M.
Drawdown _____ ft. after _____ hours _____ G.P.M.

USE OF WATER irrigation Temp. _____ °F. _____, 19____

SOURCE OF INFORMATION GR-2706

DRILLER or DIGGER _____

ADDITIONAL DATA:

Log _____ Water Level Measurements _____ Chemical Analysis _____ Aquifer Test _____

REMARKS: