

STATE ENGINEER
Salem, Oregon

*Bent
1631*

Well Record

STATE WELL NO. 10/3W-31G
COUNTY Benton Linn
APPLICATION NO. GR-3013

OWNER: S. J. Frey


MAILING ADDRESS: Route 1, Box 1884

LOCATION OF WELL: Owner's No. _____

CITY AND STATE: Sweethome, Oregon

SW $\frac{1}{4}$ NE $\frac{1}{4}$ Sec. 31 T. 10 N. S., R. 3 E. W., W.M.

Bearing and distance from section or subdivision corner From point at intersection of Spring Hill road with upper loop road E. 360' and S. 165' to well

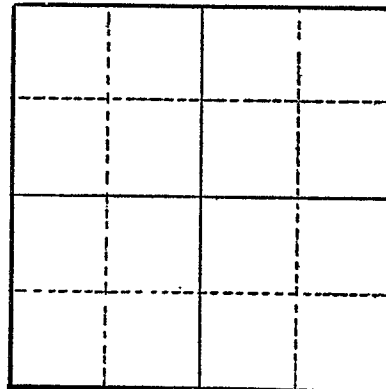

Section _____

Altitude at well _____

TYPE OF WELL: drilled Date Constructed 1952

Depth drilled 32 Depth cased 32 feet

CASING RECORD:

8 inches

FINISH:

AQUIFERS:

WATER LEVEL:

14 feet

PUMPING EQUIPMENT: Type Goulds
Capacity 100 G.P.M.

H.P. 5

WELL TESTS:

Drawdown 1 ft. after _____ hours Pumping 100 G.P.M.

Drawdown _____ ft. after _____ hours _____ G.P.M.

USE OF WATER Irrigation Temp. _____ °F. _____, 19____

SOURCE OF INFORMATION GR-2821

DRILLER or DIGGER Nichols Claus, Rt., 3, Albany, Oregon

ADDITIONAL DATA:

Log _____ Water Level Measurements _____ Chemical Analysis _____ Aquifer Test _____

REMARKS: