

OWNER: Marion W. Wilson


MAILING ADDRESS: Route 4, Box 592

LOCATION OF WELL: Owner's No.

CITY AND STATE: Albany, Oregon

NE 1/4 SE 1/4 Sec. 31 T. 10 N. S., R. 3 E. W., W.M.

Bearing and distance from section or subdivision corner 1384' N. and 4092' E.

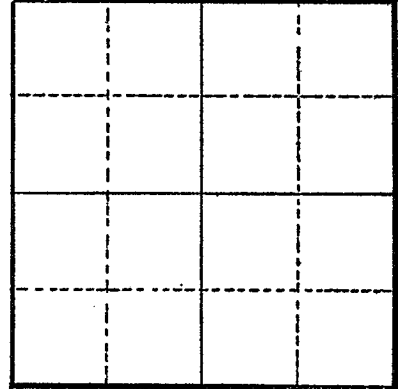

Section

Altitude at well

TYPE OF WELL: drilled Date Constructed 1953

Depth drilled 34' Depth cased 34'

CASING RECORD:

6"

FINISH:

slot perforations from 26 to 34

AQUIFERS:

WATER LEVEL:

PUMPING EQUIPMENT: Type Gould 1" Cent. H.P. 1
Capacity 30 G.P.M.

WELL TESTS:

Drawdown ft. after hours G.P.M.
Drawdown ft. after hours G.P.M.

USE OF WATER Irrigation Temp. °F., 19

SOURCE OF INFORMATION GR-3186

DRILLER or DIGGER Nicholas Klaus Route 4, Albany, Oregon

ADDITIONAL DATA:

Log Water Level Measurements Chemical Analysis Aquifer Test

REMARKS: