


STATE ENGINEER
Salem, Oregon

Well Record

Bent STATE WELL NO. 10/3W-31K
1637 COUNTY Benton
APPLICATION NO. GR-3781

OWNER: Emerald L. and Bulah M. Johnston MAILING ADDRESS: Route 4, Box 551
LOCATION OF WELL: Owner's No. _____ CITY AND STATE: Albany, Oregon

W $\frac{1}{4}$ SE $\frac{1}{4}$ Sec. 31 T. 10 S., R. 3 W., W.M.
Bearing and distance from section or subdivision
corner 3003' S. & 1782' W. of NE Cor. Sec. 31

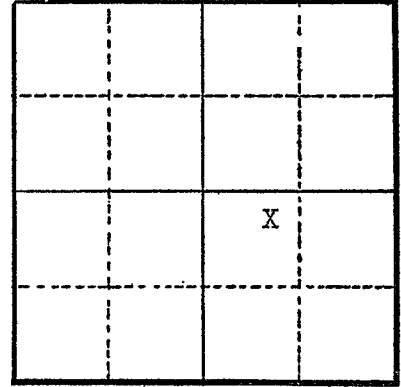

Section 31

Altitude at well _____

TYPE OF WELL: Drilled Date Constructed 1950
Depth drilled 30 feet Depth cased 30 feet

CASING RECORD:

6 inch steel casing set from 6 to 30 feet

FINISH:

slot perforations from 20 to 30 feet

AQUIFERS:

WATER LEVEL:

15 feet below surface

PUMPING EQUIPMENT: Type Pacific 1 $\frac{1}{2}$ " centrifugal H.P. 5
Capacity 100 G.P.M.

WELL TESTS:

Drawdown _____ ft. after _____ hours _____ G.P.M.
Drawdown _____ ft. after _____ hours _____ G.P.M.

USE OF WATER Irrigation Temp. _____ °F., 19 _____

SOURCE OF INFORMATION Well Registration Statement

DRILLER or DIGGER Nicholas Klaus

ADDITIONAL DATA:

Log _____ Water Level Measurements _____ Chemical Analysis _____ Aquifer Test _____

REMARKS:

3438