

STATE ENGINEER
Salem, Oregon

Well Record *Bent 1638*

STATE WELL NO. 10/3W - 31L
COUNTY BENTON
APPLICATION NO. GR-2204

OWNER: Larry H. and Marie G. Barnes


MAILING ADDRESS: 1445 Shady Lane

LOCATION OF WELL: Owner's No. _____

CITY AND STATE: Albany, Oregon

NE 1/4 SW 1/4 Sec. 31 T. 10 N. S., R. 3 E. W., W.M.

Bearing and distance from section or subdivision corner S. 45° 03' W. 13.80 *Chain*

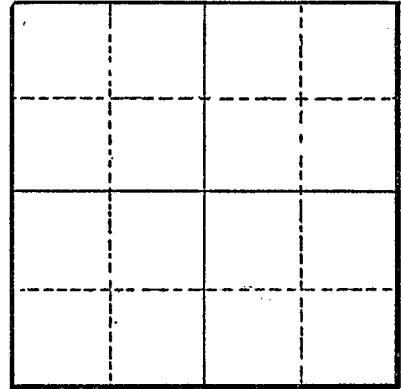

Section _____

Altitude at well _____

TYPE OF WELL: Drilled Date Constructed 1952

Depth drilled 40 Depth cased 40

CASING RECORD:

6-Inch

FINISH:

Perforations from 32 to 40

AQUIFERS:

WATER LEVEL:

13-Feet

PUMPING EQUIPMENT: Type Cornell Centrifugal H.P. 2
Capacity 50 G.P.M.

WELL TESTS:
Drawdown 17 ft. after _____ hours Pumping 25 G.P.M.
Drawdown _____ ft. after _____ hours _____ G.P.M.

USE OF WATER Irrigation Temp. _____ °F. _____, 19.

SOURCE OF INFORMATION GR-2109
DRILLER or DIGGER Nicholas Klaus, Rt, 4, Albany, Oregon

ADDITIONAL DATA:
Log _____ Water Level Measurements _____ Chemical Analysis _____ Aquifer Test _____

REMARKS: