

STATE ENGINEER
Salem, Oregon

Well Record

Bent STATE WELL NO. 10/3W-310
1646 COUNTY Benton
APPLICATION NO. GR-3768

OWNER: C. F. Hughson


MAILING ADDRESS: 1225 Springhill Rd.

LOCATION OF WELL: Owner's No. _____

CITY AND STATE: Albany, Oregon

SW $\frac{1}{4}$ SE $\frac{1}{4}$ Sec. 31 T. 10 S., R. 3 W., W.M.

Bearing and distance from section or subdivision
corner 500' N. & 1500' W. of SE Cor. to Sec. 31

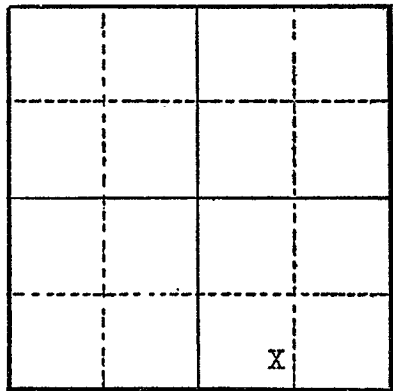

Section 31

Altitude at well _____

TYPE OF WELL: Drilled Date Constructed 6/1/51

Depth drilled 35 feet Depth cased 35 feet

CASING RECORD:

8 inch casing from 10 feet to 35 feet

FINISH:

10 per foot 8 feet 8' long from 27 to 35 feet

AQUIFERS:

WATER LEVEL:

15 feet below surface

PUMPING EQUIPMENT: Type Fairbanks & Allis Chalmers H.P. 10 & 15
Capacity _____ G.P.M.

WELL TESTS:

Drawdown 2 ft. after _____ hours 350 G.P.M.
Drawdown _____ ft. after _____ hours _____ G.P.M.

USE OF WATER Irrigation Temp. _____ °F., 19 _____

SOURCE OF INFORMATION Well Registration Statement

DRILLER or DIGGER Nick Clause

ADDITIONAL DATA:

Log X Water Level Measurements _____ Chemical Analysis _____ Aquifer Test _____

REMARKS:

Log: Sand Thickness 15
Gravel Depth to Bottom 20

3429