

STATE ENGINEER
Salem, Oregon

*Bent
1652*

Well Record

STATE WELL NO. 10/3W-32P
COUNTY Benton
APPLICATION NO. GR-1343

GR- 1299

OWNER: Urie E. Kenagy


MAILING ADDRESS: Rt. 4, Box 600

LOCATION OF WELL: Owner's No. _____

CITY AND STATE: Albany, Oregon

SE $\frac{1}{4}$ SW $\frac{1}{4}$ Sec. 32 T. 10 S., R. 3 W., W.M.

Bearing and distance from section or subdivision
corner 1450' E. & 1200' N. from SW cor. Sec. 32.

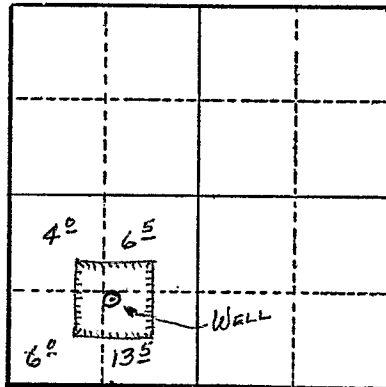

Section 32

Altitude at well 180 ft.

TYPE OF WELL: Dug Date Constructed 1938

Depth drilled 18 ft. Depth cased 18 ft.

CASING RECORD:

18 inch concrete tile

FINISH:

Perforated by chipped flanges on concrete tile from 10 to 18 ft.

AQUIFERS:

WATER LEVEL:

9 ft.

PUMPING EQUIPMENT: Type Pacific 2 in. Cent.

H.P. 7 $\frac{1}{2}$

Capacity 168 G.P.M.

WELL TESTS:

Drawdown 8 ft. after _____ hours 168 G.P.M.

Drawdown _____ ft. after _____ hours _____ G.P.M.

USE OF WATER Irrigation Temp. _____ °F., 19 _____

SOURCE OF INFORMATION G. R. Record

DRILLER or DIGGER _____

ADDITIONAL DATA:

Log N.A. Water Level Measurements _____ Chemical Analysis _____ Aquifer Test _____

REMARKS:

Irrigation of 30 acres.