

STATE ENGINEER  
Salem, Oregon

OBSERVATION WELL  
Well Record

STATE WELL NO. 10/3W-32E(1)  
COUNTY Benton  
APPLICATION NO. GR-764

OWNER: D. E. Nebergall


MAILING ADDRESS: Route 4, Box 602

LOCATION OF WELL: Owner's No. 1

CITY AND STATE: Albany, Oregon

SW 1/4 NW 1/4 Sec. 32 T. 10 N. S, R. 3 E. W., W.M.

Bearing and distance from section or subdivision  
corner 1055' N. 29° 50' E. from SW corner  
of Section 32.

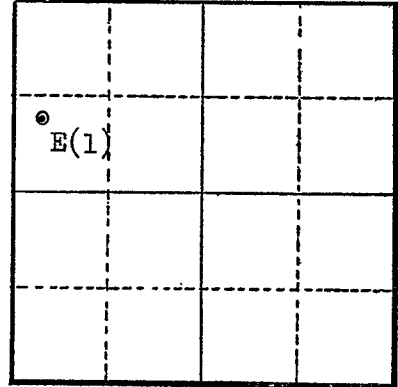

Section 32

Altitude at well 190' Interpolated

TYPE OF WELL: Drilled Date Constructed July 1935

Depth drilled 90' Depth cased 90'

CASING RECORD:

12" steel

FINISH:

Slot perforations 60' to 90'

AQUIFERS:

WATER LEVEL:

20'

PUMPING EQUIPMENT: Type Elect. - Pacific deep well H.P. 5  
Capacity 150 G.P.M.

WELL TESTS:

Drawdown 40 ft. after 100 hours G.P.M.

Drawdown ft. after hours G.P.M.

USE OF WATER Irrigation Temp. °F. 19

SOURCE OF INFORMATION GR-764

DRILLER or DIGGER W. E. Sloper, Independence

ADDITIONAL DATA:

Log None Water Level Measurements Chemical Analysis Aquifer Test

REMARKS: