

STATE ENGINEER
Salem, Oregon

*Bent
7654* Well Record


STATE WELL NO. 10/3W-32M
COUNTY BENTON
APPLICATION NO. GR-2780

OWNER: Gordon J. or Dorothy E. Keebler MAILING ADDRESS: Rt. 4, Box 598,

LOCATION OF WELL: Owner's No. CITY AND STATE: Albany, Oregon

NW 1/4 SW 1/4 Sec. 32 T. 10 N. S., R. 3 E. W., W.M.

Bearing and distance from section or subdivision corner S. 1° 46' E. 884'

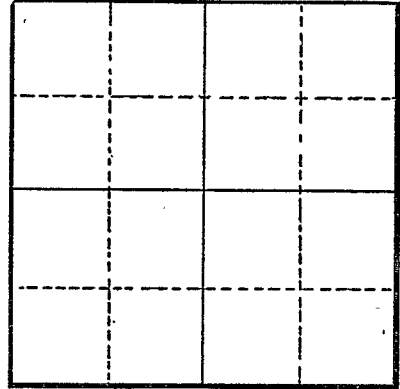

Section

Altitude at well

TYPE OF WELL: drilled Date Constructed 1952

Depth drilled 40 Depth cased 40

CASING RECORD:

10-inch

FINISH:

Slot perforations from 30 to 40

AQUIFERS:

WATER LEVEL:

18-feet

PUMPING EQUIPMENT: Type Fairbanks Morse Turbine H.P. 5
Capacity 200 G.P.M.

WELL TESTS:

Drawdown 0 ft. after hours Pumping 350 G.P.M.
Drawdown ft. after hours G.P.M.

USE OF WATER irrigation Temp. °F. 19

SOURCE OF INFORMATION GR-2627

DRILLER or DIGGER Bill Hamilton Drilling co., 838 E. third Ave., Albany, Oregon

ADDITIONAL DATA:

Log Water Level Measurements Chemical Analysis Aquifer Test

REMARKS: