

*Bent
1655*

Well Record


STATE WELL NO. 10/3W-32N
COUNTY Benton
APPLICATION NO. GR-3769

OWNER: C. F. Hughson MAILING ADDRESS: 1225 Springhill Rd.

LOCATION OF WELL: Owner's No. CITY AND STATE: Albany, Oregon

SW $\frac{1}{4}$ SW $\frac{1}{4}$ Sec. 32 T. 10 S., R. 3 W., W.M.

Bearing and distance from section or subdivision corner 350' N. & 510' E. of the SW Cor. Sec. 32

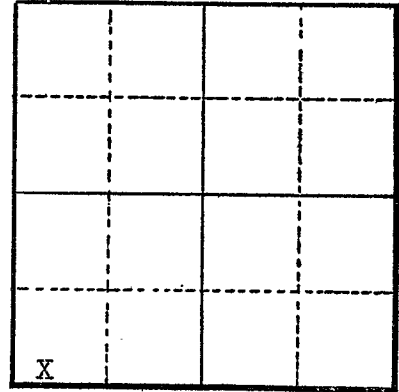

Altitude at well

TYPE OF WELL: Drilled Date Constructed 5/15/47

Depth drilled 28 feet Depth cased 28 feet

Section 32

CASING RECORD:

18 inch casing set to 28 feet

FINISH:

12 perforations from 18 to 28 feet

AQUIFERS:

WATER LEVEL:

20 feet below surface

PUMPING EQUIPMENT: Type Fairbanks & Allis Chalmers H.P. 10-15
Capacity G.P.M.

WELL TESTS:

Drawdown 10 ft. after 350 hours G.P.M.
Drawdown ft. after hours G.P.M.

USE OF WATER Irrigation Temp. °F., 19

SOURCE OF INFORMATION Well Registration Statement

DRILLER or DIGGER

ADDITIONAL DATA:

Log X Water Level Measurements Chemical Analysis Aquifer Test

REMARKS:

Log:	Thickness	Depth to Bottom
Sand	10	18
Gravel	10	28

3430