

STATE ENGINEER
Salem, Oregon

*Bent
1700*

Well Record

STATE WELL NO. 10/4W-10R(1)
COUNTY Benton
APPLICATION NO. GR-446

OWNER: Kenneth Holmes


MAILING ADDRESS: Route 4, Box 517

LOCATION OF WELL: Owner's No. 1

CITY AND STATE: Albany, Oregon

SE 1/4 SE 1/4 Sec. 10 T. 10 S., R. 4 W., W.M.

Bearing and distance from section or subdivision corner 334' S. 34° 30' W. of 1" iron pipe

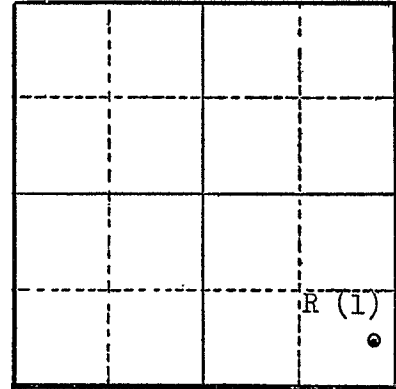

Section 10

Altitude at well 180

TYPE OF WELL: Drilled Date Constructed 1950

Depth drilled 20 Depth cased 20

CASING RECORD:

10"

FINISH:

AQUIFERS:

WATER LEVEL:

8'

PUMPING EQUIPMENT: Type Fairbanks Morse centrifugal H.P. 10

Capacity 200 G.P.M.

WELL TESTS:

Drawdown ft. after hours G.P.M.

Drawdown ft. after hours G.P.M.

USE OF WATER Dom. & Irrigation of 126.2 Temp. °F., 19.....

SOURCE OF INFORMATION GR-446

DRILLER or DIGGER Bill Hamilton; Albany, Oregon

ADDITIONAL DATA:

Log No Water Level Measurements Chemical Analysis Aquifer Test

REMARKS: