


OWNER: Kenneth Holmes MAILING ADDRESS: Route 4, Box 517

LOCATION OF WELL: Owner's No. #2 CITY AND STATE: Albany, Oregon

SW 1/4 SW 1/4 Sec. 11 T. 10 S. R. 4 W., W.M.

Bearing and distance from section or subdivision corner 1150' S. 60° E. of 1" pipe

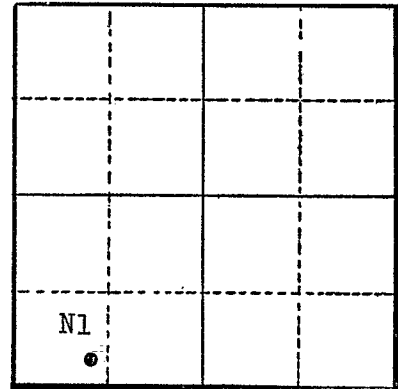

Section 11

Altitude at well _____

TYPE OF WELL: Dug & Dr. Date Constructed 1954

Depth drilled 26 Depth cased 26

CASING RECORD:

8"

FINISH:

AQUIFERS:

WATER LEVEL:

12'

PUMPING EQUIPMENT: Type Fairbanks Morse Centrifugal H.P. 10
Capacity 200 G.P.M.

WELL TESTS:

Drawdown _____ ft. after _____ hours _____ G.P.M.

Drawdown _____ ft. after _____ hours _____ G.P.M.

USE OF WATER Dom. Irrigation of 27.2 Temp. _____ °F. _____, 19_____

SOURCE OF INFORMATION GR-446

DRILLER or DIGGER Bill Hamilton, Albany, Oregon

ADDITIONAL DATA:

Log No Water Level Measurements _____ Chemical Analysis _____ Aquifer Test _____

REMARKS:

Dug 4' pit, 8-inch casing 4 to 26'