

STATE ENGINEER
Salem, Oregon

Original Lien Co.

Well Record

*sent
1/16*

STATE WELL NO. 10/LW-11A(1)
COUNTY _____
APPLICATION NO. GR-475

Benton

OWNER: Charles & Patricia Chambers


MAILING ADDRESS: Rt. 2, Box 329

LOCATION OF WELL: Owner's No. 2

CITY AND STATE: Albany, Oregon

NE $\frac{1}{4}$ NE $\frac{1}{4}$ Sec. 11 T. 10 N. S., R. 4 E. W., W.M.

Bearing and distance from section or subdivision
corner S. 68° E. 25.2 chs. from NW cor. Elias A.
Johnson DLC 74

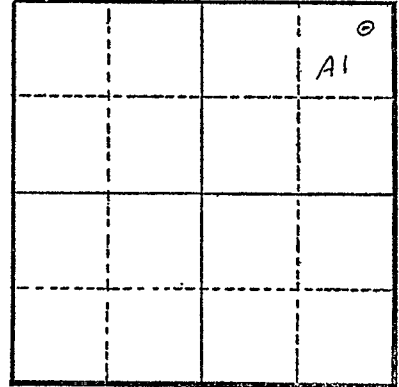

Section 11

Altitude at well 175 ft.

TYPE OF WELL: drilled Date Constructed 4/11/51

Depth drilled 29 ft. Depth cased 29 ft.

CASING RECORD: 8 inch

FINISH:

AQUIFERS:

WATER LEVEL: 8 ft.

PUMPING EQUIPMENT: Type Pacific centrifugal H.P. 20
Capacity 500 G.P.M.

WELL TESTS:

Drawdown 2.5 ft. after _____ hours 700 G.P.M.

Drawdown _____ ft. after _____ hours _____ G.P.M.

USE OF WATER irrigation 52.6 acres Temp. _____ °F., 19.

SOURCE OF INFORMATION GR-475

DRILLER or DIGGER _____

ADDITIONAL DATA:

Log _____ Water Level Measurements _____ Chemical Analysis _____ Aquifer Test _____

REMARKS: