

STATE ENGINEER
Salem, Oregon

Well Record

Bent
1721

STATE WELL NO. 10/4W-14D(1)
COUNTY Benton
APPLICATION NO. GR-446

OWNER: Kenneth Holmes


MAILING ADDRESS: Rt. 4, Box 517

LOCATION OF WELL: Owner's No. #3

CITY AND STATE: Albany, Oregon

NW 1/4 NW 1/4 Sec. 14 T. 10 S. R. 4 W., W.M.

Bearing and distance from section or subdivision corner 833' N. 75° W. of 3/4" pipe located as common cor. of Holmes Hill & Jordan property

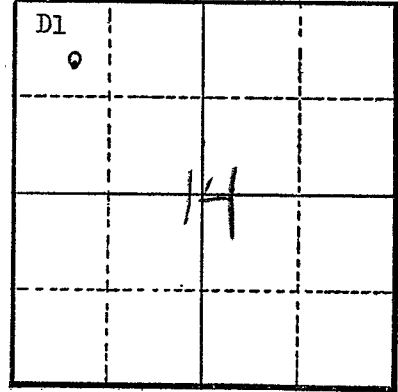

Section 14

Altitude at well 181

TYPE OF WELL: Dug & Dr. Date Constructed 1952

Depth drilled 35 Depth cased 35

CASING RECORD:

8" casing from 8 to 35'. 6 x 6' and 8' deep pit dug

FINISH:

AQUIFERS:

WATER LEVEL:

22

PUMPING EQUIPMENT: Type Allis Chalmers, centrifugal H.P. 10
Capacity 200 G.P.M.

WELL TESTS:

Drawdown ft. after hours G.P.M.
Drawdown ft. after hours G.P.M.

USE OF WATER Domestic & Irrigation of 46.6 A. Temp. °F. 19

SOURCE OF INFORMATION GR-446

DRILLER or DIGGER Art. Clinton, Independence, Ore.

ADDITIONAL DATA:

Log No. Water Level Measurements Chemical Analysis Aquifer Test

REMARKS: