

STATE ENGINEER
Salem, Oregon

Well Record

Bent
1723

STATE WELL NO. 10/4W-14E (1)
COUNTY Benton
APPLICATION NO. GR-429

OWNER: Dave H. Jordan


MAILING ADDRESS: Rt. 4, Box 159

LOCATION OF WELL: Owner's No. _____

CITY AND STATE: Albany, Oregon

SW 1/4 NW 1/4 Sec. 14 T. 10 ^{N.}S, R. 4 ^{E.}W., W.M.

Bearing and distance from section or subdivision corner 790' S. 77° W. of 1 1/4" axle shaft which is the SE corner of Smiley Carter DLC

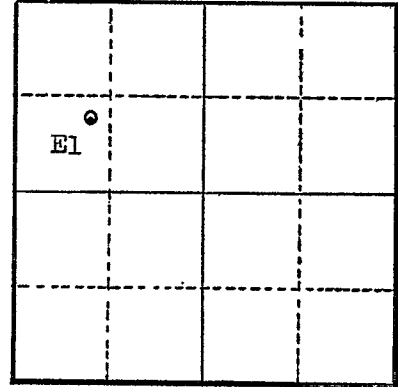

Section 14

Altitude at well 180

TYPE OF WELL: _____ Date Constructed _____

Depth drilled _____ Depth cased _____

CASING RECORD:

8"

FINISH:

AQUIFERS:

WATER LEVEL:

18

PUMPING EQUIPMENT: Type Fairbanks Morse 3" x 4" H.P. 15
Capacity 250 G.P.M.

WELL TESTS:

Drawdown 10 ft. after _____ hours 230 G.P.M.
Drawdown _____ ft. after _____ hours _____ G.P.M.

USE OF WATER Irrigation of 40 acres Temp. _____ °F. _____, 19.

SOURCE OF INFORMATION GR-429

DRILLER or DIGGER -

ADDITIONAL DATA:

Log No Water Level Measurements _____ Chemical Analysis _____ Aquifer Test _____

REMARKS:

Dug to depth of 8' casing is 8" from 8' to 30'.