

STATE ENGINEER  
Salem, Oregon

# Well Record

*rent  
725*

STATE WELL NO. 10/4W-14G  
COUNTY BENTON  
APPLICATION NO. GR-2865

OWNER: G. W. Hill


MAILING ADDRESS: Rt. 4, Box 521

LOCATION OF WELL: Owner's No. #4

CITY AND STATE: Albany, Oregon

SW 1/4 NE 1/4 Sec. 14 T. 10 N. S., R. 4 E. W., W.M.

Bearing and distance from section or subdivision corner 2000' S. & 200' E.

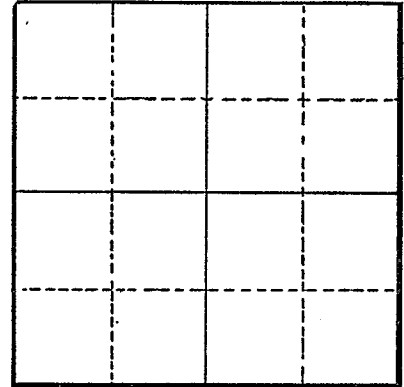

Section .....

Altitude at well .....

TYPE OF WELL: drilled Date Constructed 1948

Depth drilled 30 Depth cased 30

### CASING RECORD:

10-inch

### FINISH:

Perforations from 18 to 28

### AQUIFERS:

Topsoil and gravel

### WATER LEVEL:

PUMPING EQUIPMENT: Type Fairbanks Centrifugal H.P. 10

Capacity 350 G.P.M.

### WELL TESTS:

Drawdown 2 ft. after ..... hours Pumping 700 G.P.M.

Drawdown ..... ft. after ..... hours ..... G.P.M.

USE OF WATER Irrigation Temp. ..... °F. ...., 19.....

SOURCE OF INFORMATION GR-2699

DRILLER or DIGGER Bill Hamilton

### ADDITIONAL DATA:

Log X Water Level Measurements ..... Chemical Analysis ..... Aquifer Test .....

### REMARKS:

Topsoil 0 16  
Gravel 16 30