

STATE ENGINEER  
Salem, Oregon

# Well Record

*rent  
1727*

STATE WELL NO. 10/4W-14M  
COUNTY Benton  
APPLICATION NO. GR-3898

OWNER: Earl Farrier


MAILING ADDRESS: Route 4, Box 522

LOCATION OF WELL: Owner's No. \_\_\_\_\_

CITY AND STATE: Albany, Oregon

NW  $\frac{1}{4}$  SW  $\frac{1}{4}$  Sec. 14 T. 10 S., R. 4 W., W.M.

Bearing and distance from section or subdivision corner 1550' N. & 320' E. from SW Cor. Sec. 14

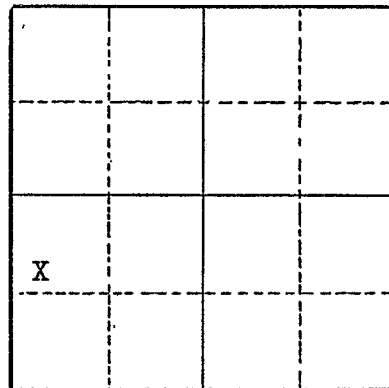

Section 14

Altitude at well \_\_\_\_\_

TYPE OF WELL: Drilled Date Constructed 1953

Depth drilled 36 ft. Depth cased 36 ft.

### CASING RECORD:

8 inch casing set to 36 feet

### FINISH:

perforations from 26 to 36 feet

### AQUIFERS:

### WATER LEVEL:

20 feet below surface

PUMPING EQUIPMENT: Type Fairbanks Morse turbine H.P. 7 $\frac{1}{2}$   
Capacity 75 G.P.M.

### WELL TESTS:

Drawdown 10 ft. after \_\_\_\_\_ hours 135 G.P.M.

Drawdown \_\_\_\_\_ ft. after \_\_\_\_\_ hours \_\_\_\_\_ G.P.M.

USE OF WATER Irrigation Temp. \_\_\_\_\_ °F. \_\_\_\_\_, 19\_\_\_\_\_

SOURCE OF INFORMATION Well Registration Statement Cert. # Gr-3541

DRILLER or DIGGER \_\_\_\_\_

### ADDITIONAL DATA:

Log \_\_\_\_\_ Water Level Measurements \_\_\_\_\_ Chemical Analysis \_\_\_\_\_ Aquifer Test \_\_\_\_\_

### REMARKS: