

STATE ENGINEER
Salem, Oregon

Well Record

Bent
1735

STATE WELL NO. 10/4W-15B
COUNTY BENTON
APPLICATION NO. GR-2900

OWNER: Mrs. J. E. Borden


MAILING ADDRESS: Route 4, Box 516

LOCATION OF WELL: Owner's No. _____

CITY AND STATE: Albany, Oregon

NW 1/4 NE 1/4 Sec. 15 T. 10 ^{N.} S, R. 4 ^{E.} W., W.M.

Bearing and distance from section or subdivision corner 20.5 chs. W. and 10.2 chs. S.

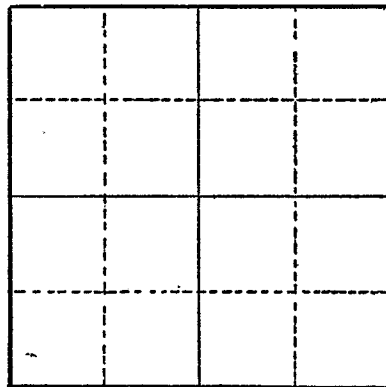

Section _____

Altitude at well _____

TYPE OF WELL: drilled Date Constructed 1953

Depth drilled 31 Depth cased 31

CASING RECORD:

10-inch

FINISH:

Yes 1/4 x 6 or 8" random from 23 to 31

AQUIFERS:

Sand, gravel and clay

WATER LEVEL:

13-feet

PUMPING EQUIPMENT: Type Fairbanks Morse Turbine H.P. 7 1/2
Capacity 200 G.P.M.

WELL TESTS:

Drawdown 25 ft. after _____ hours Pumping 150 G.P.M.

Drawdown _____ ft. after _____ hours _____ G.P.M.

USE OF WATER Irrigation Temp. _____ °F. _____, 19_____

SOURCE OF INFORMATION GR-2729

DRILLER or DIGGER Shafer & Hamilton

ADDITIONAL DATA:

Log Water Level Measurements _____ Chemical Analysis _____ Aquifer Test _____

REMARKS:

Sand & gravel
Blue clay