

*Bent*  
*1739*

OWNER: E. H. Widmer


MAILING ADDRESS: 245 Quarry Road

LOCATION OF WELL: Owner's No. \_\_\_\_\_

CITY AND STATE: Albany, Oregon

NW 1/4 NW 1/4 Sec. 15 T. 10 S., R. 4 W., W.M.

Bearing and distance from section or subdivision corner 990' S. & 396' E. of NW Cor. Sec. 15

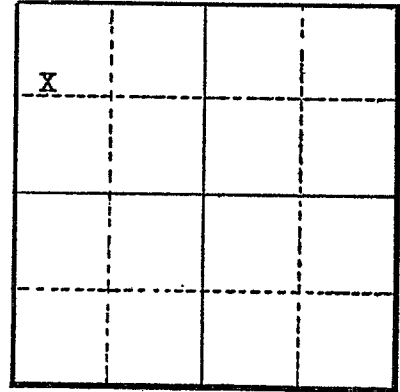

Section 15

Altitude at well \_\_\_\_\_

TYPE OF WELL: Drilled Date Constructed 1938

Depth drilled 20 feet Depth cased 20 feet

CASING RECORD:

8 inch casing set to 20 feet

FINISH:

Slot perforations from 12 to 20 feet

AQUIFERS:

WATER LEVEL:

PUMPING EQUIPMENT: Type Fairbanks Morse centrifugal H.P. 7 1/2  
Capacity \_\_\_\_\_ G.P.M.

WELL TESTS:

Drawdown \_\_\_\_\_ ft. after \_\_\_\_\_ hours \_\_\_\_\_ G.P.M.  
Drawdown \_\_\_\_\_ ft. after \_\_\_\_\_ hours \_\_\_\_\_ G.P.M.

USE OF WATER Irrigation Temp. \_\_\_\_\_ °F. \_\_\_\_\_, 19\_\_\_\_

SOURCE OF INFORMATION Well Registration Statement

DRILLER or DIGGER \_\_\_\_\_

ADDITIONAL DATA:

Log \_\_\_\_\_ Water Level Measurements \_\_\_\_\_ Chemical Analysis \_\_\_\_\_ Aquifer Test \_\_\_\_\_

REMARKS:

*3461*