

STATE ENGINEER
Salem, Oregon

Well Record *Bent 1740*

STATE WELL NO. 10/4W-15H
COUNTY BENTON
APPLICATION NO. GR-2862

OWNER: Leland Hill


MAILING ADDRESS: Rt. 4, Box 520 L

LOCATION OF WELL: Owner's No. #3

CITY AND STATE: Albany, Oregon

SE 1/4 NE 1/4 Sec. 15 T. 10 S., R. 4 W., W.M.

Bearing and distance from section or subdivision corner 480' W. & 1960' S.

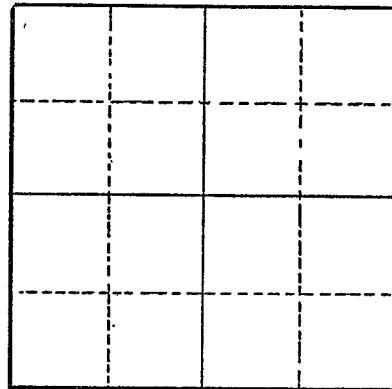

Section

Altitude at well

TYPE OF WELL: drilled Date Constructed 1941

Depth drilled 30 Depth cased 30

CASING RECORD:

10-inch

FINISH:

Lost to 10'

AQUIFERS:

Topsoil, sand, gravel and clay

WATER LEVEL:

10-feet

PUMPING EQUIPMENT: Type Centrifugal
Capacity 400 G.P.M.

H.P. 20

WELL TESTS:

Drawdown 8 ft. after hours Pumping 450 G.P.M.

Drawdown 6 ft. after hours Pumping 350 G.P.M.

USE OF WATER Irrigation Temp. °F., 19.....

SOURCE OF INFORMATION GR-2696

DRILLER or DIGGER

ADDITIONAL DATA:

Log X Water Level Measurements Chemical Analysis Aquifer Test

REMARKS:

Topsoil 0 to 8
Sand 8 to 18
Gravel 18 to 30
Blue Clay 30