

STATE ENGINEER
Salem, Oregon

Well Record

Bent
1741

STATE WELL NO. 10/4W-15J
COUNTY BENTON
APPLICATION NO. GR-2864

OWNER: Ival T. Hill


MAILING ADDRESS: Rt. 4, Box 520

LOCATION OF WELL: Owner's No. #1

CITY AND STATE: Albany, Oregon

NE 1/4 SE 1/4 Sec. 15 T. 10 S., R. 4 W., W.M.

Bearing and distance from section or subdivision corner 120' S. and 430' W.

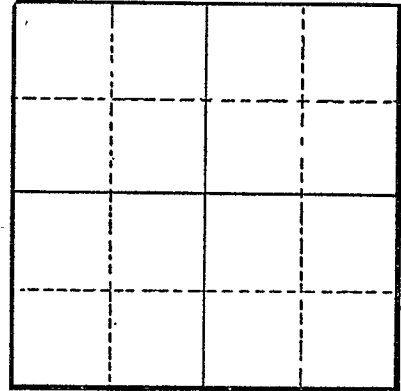

Section

Altitude at well

TYPE OF WELL: drilled Date Constructed 1948

Depth drilled 33 Depth cased 33

CASING RECORD:

10-inch

FINISH:

Yes from 20 to 30

AQUIFERS:

Topsoil and gravel

WATER LEVEL:

S. - 6' F. - 16'

PUMPING EQUIPMENT: Type Centrifugal

H.P. 20

Capacity 500 G.P.M.

WELL TESTS:

Drawdown 10 ft. after hours Pumping 500 G.P.M.

Drawdown ft. after hours G.P.M.

USE OF WATER Irrigation Temp. °F., 19.....

SOURCE OF INFORMATION GR-2698

DRILLER or DIGGER Bill Hamilton

ADDITIONAL DATA:

Log Water Level Measurements Chemical Analysis Aquifer Test

REMARKS:

Topsoil 0 to 4
Gravel 4 to 33