

STATE ENGINEER
Salem, Oregon

Well Record

Bent
1742
STATE WELL NO. 10/4W-15J
COUNTY Benton
APPLICATION NO. GR-2863

OWNER: Ival T. Hill


MAILING ADDRESS: Rt. 4, Box 520

LOCATION OF WELL: Owner's No. #2

CITY AND STATE: Albany, Oregon

NE 1/4 SE 1/4 Sec. 15 T. 10 S., R. 4 W., W.M.

Bearing and distance from section or subdivision corner 990' S. & 1120' W.

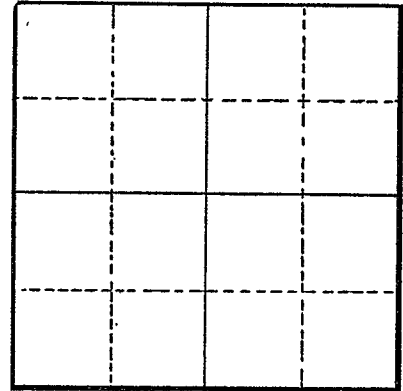

Section

Altitude at well

TYPE OF WELL: drilled Date Constructed 1951

Depth drilled 35 Depth cased 35

CASING RECORD:

8-inch

FINISH:

Perforated casing from 23 to 33

AQUIFERS:

Topsoil and gravel

WATER LEVEL:

15-feet

PUMPING EQUIPMENT: Type Centrifugal

H.P. 5

Capacity 200 G.P.M.

WELL TESTS:

Drawdown 12 ft. after hours Pumping 180 G.P.M.

Drawdown ft. after hours G.P.M.

USE OF WATER Irrigation

Temp. °F., 19

SOURCE OF INFORMATION GR-2697

DRILLER or DIGGER Art Clinton

ADDITIONAL DATA:

Log Water Level Measurements Chemical Analysis Aquifer Test

REMARKS:

Topsoil 0 to 18
Gravel 18 to 35