

STATE ENGINEER
Salem, Oregon

*sent
2044*

Well Record

STATE WELL NO. 10/4W - 35H
COUNTY LINN
APPLICATION NO. GR-2244

OWNER: Nelson John Zeller


MAILING ADDRESS: 1616 East Front Ave.

LOCATION OF WELL: Owner's No. _____

CITY AND STATE: Albany, Oregon

SE $\frac{1}{4}$ NE $\frac{1}{4}$ Sec. 35T. 10 ^{N.} S., R. 4 ^{E.} W., W.M.

Bearing and distance from section or subdivision corner S. 75° W. 1584'

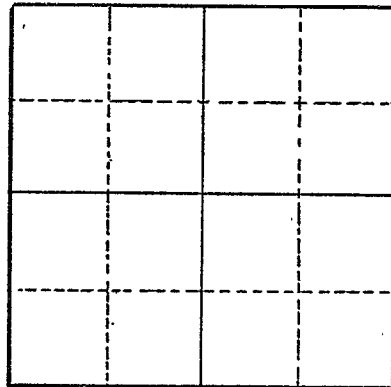

Section _____

Altitude at well _____

TYPE OF WELL: Drilled Date Constructed 1952

Depth drilled 196 Depth cased _____

CASING RECORD:

6-Inch

FINISH:

AQUIFERS:

WATER LEVEL:

PUMPING EQUIPMENT: Type Jacuzzi Jet H.P. 1
Capacity _____ G.P.M.

WELL TESTS:

Drawdown _____ ft. after _____ hours _____ G.P.M.

Drawdown _____ ft. after _____ hours _____ G.P.M.

USE OF WATER Irrigation Temp. _____ °F. _____, 19____

SOURCE OF INFORMATION GR-2145

DRILLER or DIGGER Nicholas Klaus, Et. 4, Albany, Oregon

ADDITIONAL DATA:

Log _____ Water Level Measurements _____ Chemical Analysis _____ Aquifer Test _____

REMARKS: