

STATE ENGINEER  
Salem, Oregon

*Bent  
2065* Well Record

STATE WELL NO. 10/4W-36E  
COUNTY Benton  
APPLICATION NO. CR-3793

OWNER: S. E. Victor

MAILING ADDRESS: Route 4, Box 312


LOCATION OF WELL: Owner's No. \_\_\_\_\_

CITY AND STATE: Albany, Oregon

SW  $\frac{1}{4}$  NW  $\frac{1}{4}$  Sec. 36 T. 10 N. S., R. 4 W. W.M.

Bearing and distance from section or subdivision

corner 1683' S. & 640' E. of NW Cor. Sec. 36

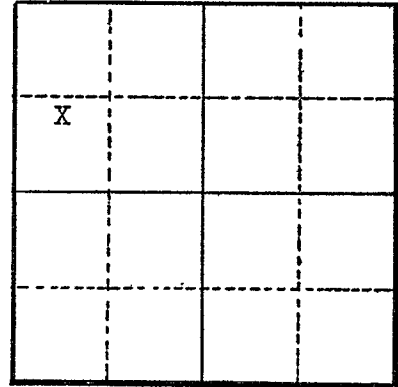

Section 36

Altitude at well \_\_\_\_\_

TYPE OF WELL: Drilled Date Constructed 1947

Depth drilled 265 feet Depth cased 265 feet

CASING RECORD:

6 inch steel casing set to 265 feet

FINISH:

Slot perforations from 245 to 265 feet

AQUIFERS:

WATER LEVEL:

PUMPING EQUIPMENT: Type Berkley centrifugal H.P. 5  
Capacity 25 G.P.M.

WELL TESTS:

Drawdown \_\_\_\_\_ ft. after \_\_\_\_\_ hours \_\_\_\_\_ G.P.M.

Drawdown \_\_\_\_\_ ft. after \_\_\_\_\_ hours \_\_\_\_\_ G.P.M.

USE OF WATER Irrigation Temp. \_\_\_\_\_ °F., 19 \_\_\_\_\_

SOURCE OF INFORMATION Well Registration Statement

DRILLER or DIGGER Nicholas Klaus

ADDITIONAL DATA:

Log \_\_\_\_\_ Water Level Measurements \_\_\_\_\_ Chemical Analysis \_\_\_\_\_ Aquifer Test \_\_\_\_\_

REMARKS:

3454