

STATE ENGINEER
Salem, Oregon

Well Record

STATE WELL NO. 10/4W-36Q
COUNTY BENTON
APPLICATION NO. GR-2143

Bent
2068

OWNER: A. P. Howell


MAILING ADDRESS: Route 4, Box 184

LOCATION OF WELL: Owner's No. _____

CITY AND STATE: Albany

SW $\frac{1}{4}$ SE $\frac{1}{4}$ Sec. 36 T. 10 S., R. 4 W., W.M.

Bearing and distance from section or subdivision corner S 58° W 4.65 chains to $\frac{1}{4}$ section corner,
Sec. 35, 36, T 10S, 4W

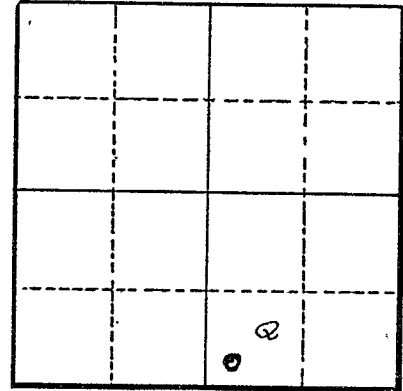

Section 36

Altitude at well _____

TYPE OF WELL: Drilled Date Constructed 1946

Depth drilled 185' Depth cased 120'

CASING RECORD:

6-inch

FINISH:

AQUIFERS:

WATER LEVEL:

25'

PUMPING EQUIPMENT: Type Berkley turbine H.P. 1 $\frac{1}{2}$
Capacity 10 G.P.M.

WELL TESTS:

Drawdown 20 ft. after _____ hours 10 G.P.M.
Drawdown _____ ft. after _____ hours _____ G.P.M.

USE OF WATER Irrigation Temp. _____ °F., 19____

SOURCE OF INFORMATION GR-3858

DRILLER or DIGGER _____

ADDITIONAL DATA:

Log NA Water Level Measurements _____ Chemical Analysis _____ Aquifer Test _____

REMARKS: