

STATE ENGINEER
Salem, Oregon

gent
2376

Well Record

STATE WELL NO. 11/3W-6C
COUNTY Benton
APPLICATION NO. GR-2548

OWNER: Chas K. McCormack, Secretary,
Cloverdale Farms, Inc.


MAILING ADDRESS: P.O. Box 392,

LOCATION OF WELL: Owner's No. # 4

CITY AND STATE: Albany, Oregon

NE 1/4 NW 1/4 Sec. 6 T. 11 S., R. 3 W., W.M.

Bearing and distance from section or subdivision
corner 1715' E. & 1315' S.

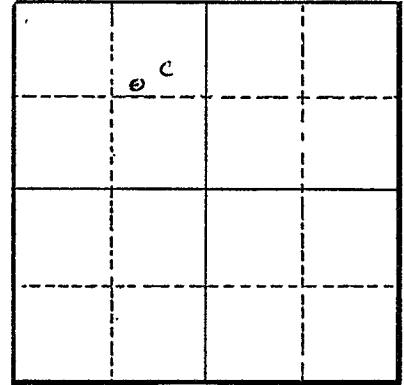

Section 6

Altitude at well _____

TYPE OF WELL: Drilled Date Constructed 1953

Depth drilled 30 Depth cased 30

CASING RECORD:

10-inch

FINISH:

AQUIFERS:

WATER LEVEL:

18-feet

PUMPING EQUIPMENT: Type Centrifugal H.P. 10
Capacity 220 G.P.M.

WELL TESTS:
Drawdown 2 ft. after _____ hours Pumping 200 G.P.M.
Drawdown _____ ft. after _____ hours _____ G.P.M.

USE OF WATER Irrigation Temp. _____ °F. _____, 19_____

SOURCE OF INFORMATION GR-2408

DRILLER or DIGGER Bill Hamilton

ADDITIONAL DATA:
Log _____ Water Level Measurements _____ Chemical Analysis _____ Aquifer Test _____

REMARKS: